

Name Barry Couette

Service No. 14

Address 194 GRANT ST.

Location

Kind of Pipe A.C.

Size 6"

Size of Main 8"

Repair—Renewal New Service Redmond #4298


Location SEP 5 1986

Date	Material	Amount	Total	Date	Amount
<del>12/01/75</del>	<del>31' L.F. 6" cl. 3300</del>	<del>\$310.00</del>		6-9-86	Deposit
	Q # 10.00 L.F.				310 00
<del>12/01/75</del>	<del>11' 3" 1" Copper</del>				
	<del>11' 3" 1" Copper</del>			6-9-86	38' 1" Copper
	<del>11' 3" 1" Copper</del>			12-8-75	
	<del>11' 3" 1" Copper</del>				31' 6" cl. 3300
12/8/86	47' 6" PVC pipe				
	6' 4" PVC pipe				
	1 4" x 6" PVC Fernco				
	1 6" x 6" AC - PVC Fernco				

TOWN OF LEXINGTON — BOARD OF PUBLIC WORKS  
SEWER DIVISION

Sketch of Service Here

194

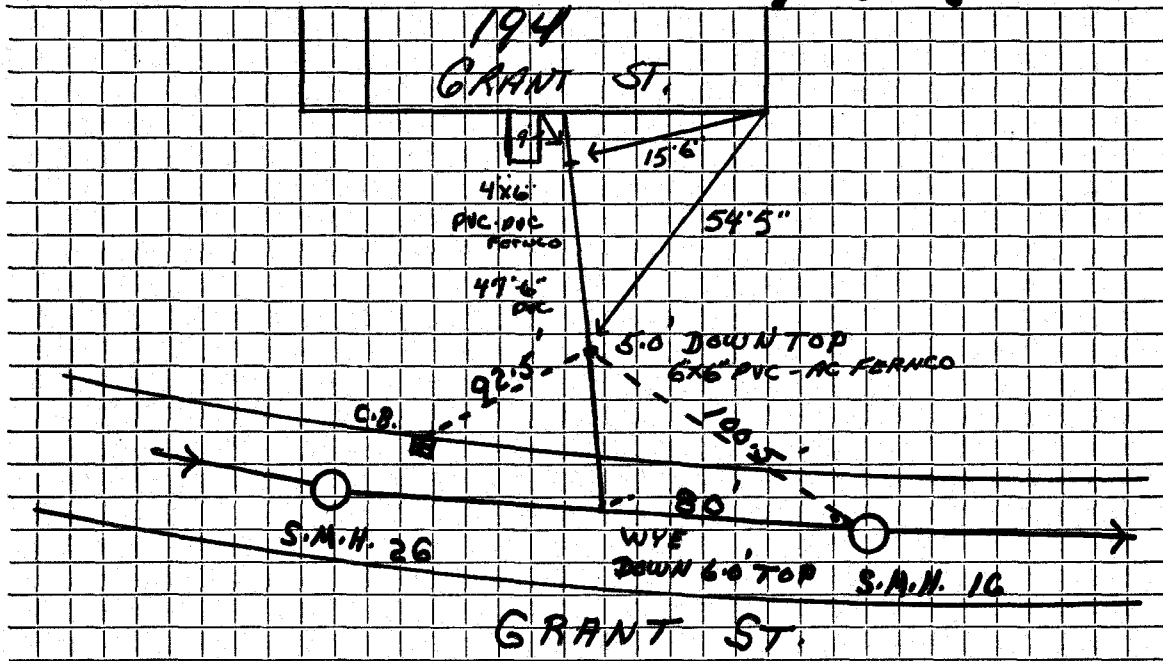

Connection made in ..... GRANT ..... Street. Work completed .....

Remarks: .....  
.....  
.....