


DATE 10-1-01

TOWN OF LEXINGTON — BOARD OF PUBLIC WORKS
SEWER DIVISION

Sketch of Service Here

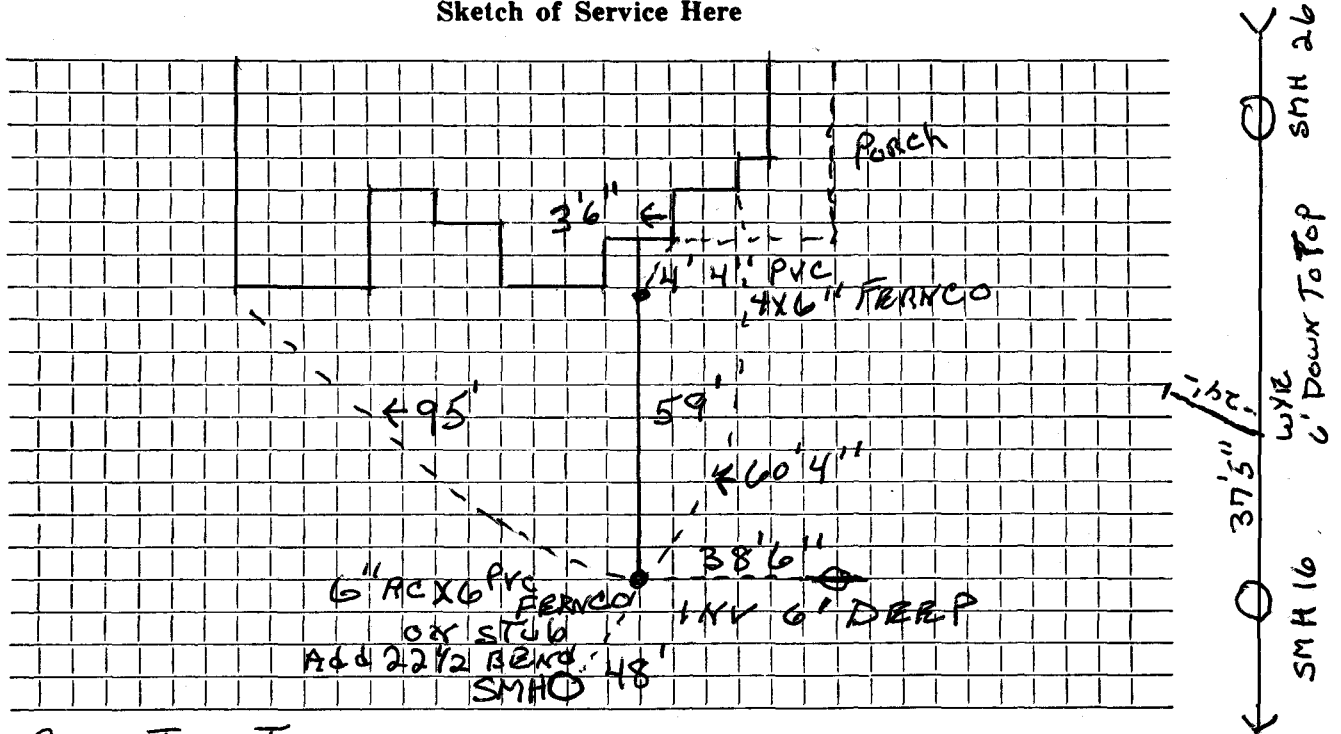

Connection made in GRANT ST. Street. Work completed

Remarks: INSTALLED BY J. McLAUGHLIN

.....
.....