

Name Barry Couette

Service No.

Address # 198 GRANT ST.

Location

Kind of Pipe H.C.

Size 6"

Size of Main 8"

Repair—Renewal—**New Service** Redmond #4610

Location


Date	Material	Amount	Total	Date	Amount
<del>12/8/75</del>	<del>31' 6" L.F. 6" cl. 3300</del> 2' 10.00 L.F.	<del>310.00</del>		10-29-86	Deposit 310.00
2/8/86	40' 6" PVC			12-8-75	
	7' 4" PVC			31' 6" cl. 3300	
	1 6" x 6" AC-PVC Fernco				
	1 4" x 6" PVC-PVC Fernco				
	1 6" x 22 1/2° Elbow				

DATE \_\_\_\_\_

TOWN OF LEXINGTON — BOARD OF PUBLIC WORKS  
SEWER DIVISION

Sketch of Service Here

198

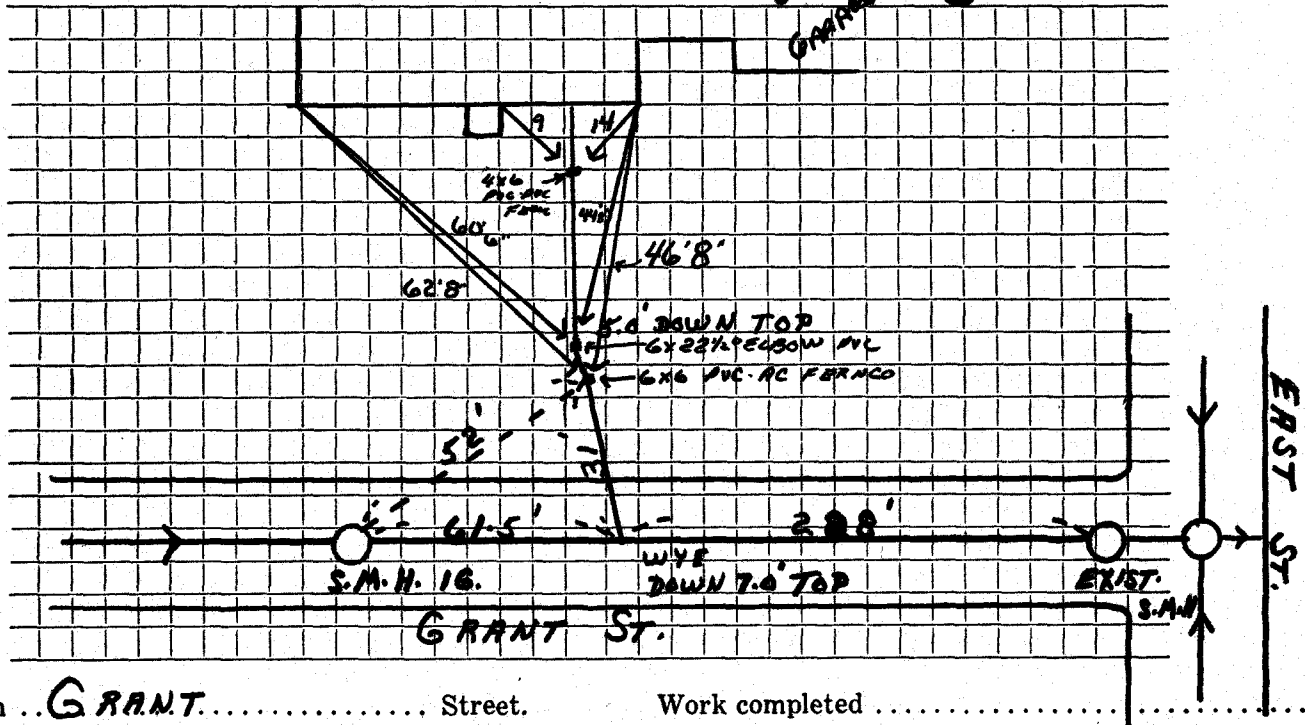

Connection made in .. GRANT ..... Street.      Work completed .....

Remarks: .....

.....

.....