

Name Paul Porter

Service No. 31

Address #203 GRANT ST.

Location

Kind of Pipe 6" Lexington Sewerage #2504

Size 6" A.C.

Size of Main 8" A.C.

Repair—Renewal—New Service

Location FEB 10 1975


Date	Material	Amount	Total	Date	Amount	
4/24/72	10.0' 6" AC @ \$9.00	\$90.00		5-29-74	Deposit	90.00
6/10/1974	33 C.I.			11-24-72		
	105' 6" AC			10' 6" A.C.		

DATE _____

TOWN OF LEXINGTON — BOARD OF PUBLIC WORKS

SEWER DIVISION

203 Sketch of Service Here

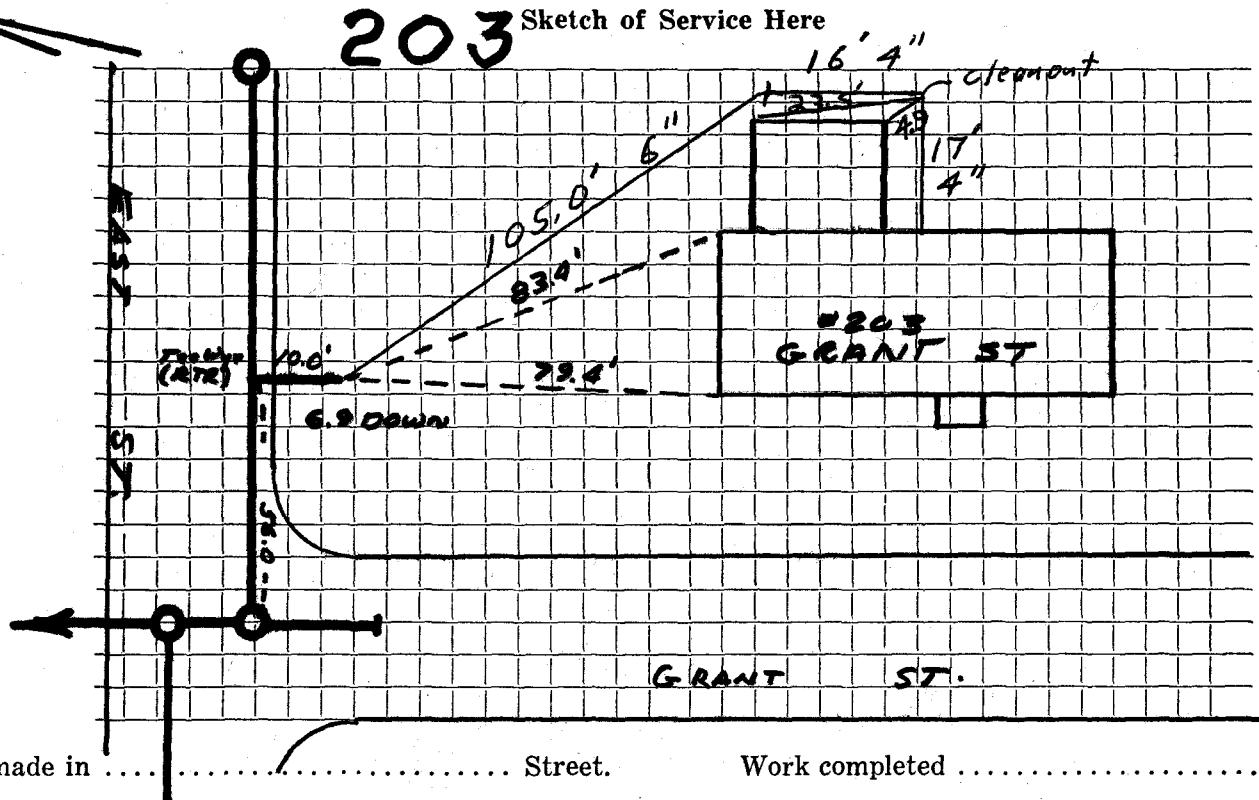

Connection made in Street. Work completed

Remarks:
.....
.....