

Name George E. Smith

Service No. 10 294

Address 34 Grant Street, Lexington, Mass.

Location 34 Grant St

Kind of Pipe

Size

Size of Main

Repair—Renewal—New Service

Location

Date 1938	Material	Amount	Total	Date	Amount
5/3/38	24 hrs. 50¢	12 00		May 3, 1938	190 00
Sum 7-5-38	96½ " 55¢	53 08		August 4, 1938	20 00
	62 " 60¢	37 20	102 28 ✓		150 00
	10% overhead		10 23 ✓		
	106' 6" Sewer Pipe @ 20¢		21 20 ✓		
	1 6 x 4 Reducer		1 00		
	Joint Compound		6 36 ✓		
	1½ bags cement		90		
	Compressor- 9 hrs. @ 3.00		27 00		
	Trucking- 2 hrs. @ 75¢		1 50 ✓	Bill: 7-8-38	
	Trench Repairs 15 x 3		10 00 ✓		
			180 47		
	Labor Charge: \$150.00				
	(see job slip)				
				Labor	102.28 -
				Overhead	10.23 -
				Pipe	21.20 -
				Trucking	1.50 -
				Joint Comp	6.36 -
				Catching	10.00 -
					150.00

TOWN OF LEXINGTON—BOARD OF PUBLIC WORKS

SEWER DIVISION

DATE 7/28/38

NO. \_\_\_\_\_


The undersigned applies for the construction of a particular sewer connecting No. 24 South St Street and hereby agrees to comply with the Rules and Regulations governing the construction and use of Particular Sewers, as now or at any future time established by the Board of Selectmen.

Am't. of Estimate \$ 130.00

Am't. Paid \$ 130.00

George E. Smith Owner

Sketch of Service Here

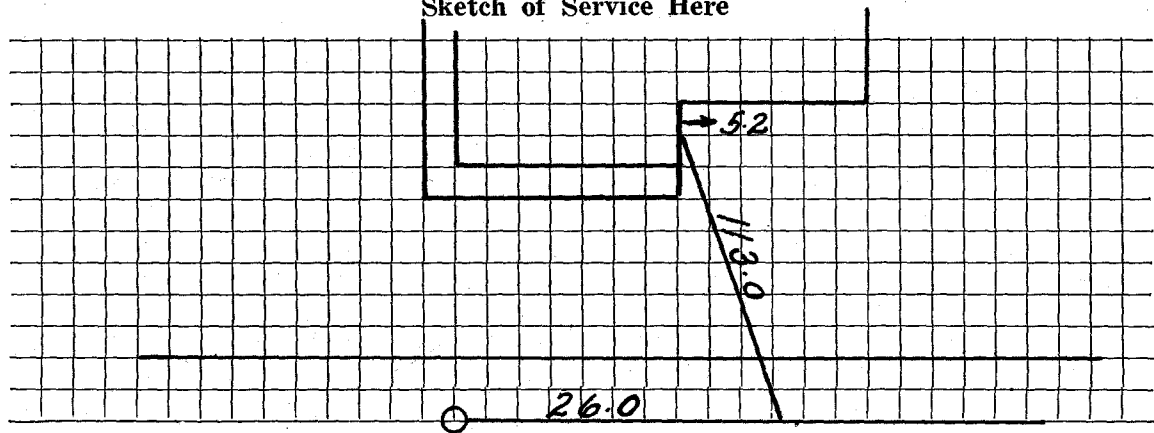

Connection made in \_\_\_\_\_ Street.

Work completed \_\_\_\_\_ 19

Remarks:

15157