

Name Katie MacPhee

Service No. 67

Address 35 Grant St.

Location

Kind of Pipe

Size

Size of Main

~~Repair~~ ~~Renewal~~ ~~New Service~~ W. O # 8103

Location JAN 17 1972


Date	Material	Amount	Total	Date	Amount
9/16/71	Labor	131 15		9-8-71	400 00
9/17/71	"	107 06		1-17-72	8 54
	10% O.H.	23 82	262 03		391 46
25'	6" Transite pipe .90		22 50		
3'	6" Nipple		4 00		
1	22 $\frac{1}{2}$ Sweep		6 83		
1	11 $\frac{1}{2}$ Ell		3 95	9/17/71	
1	Donut		2 65	25'	6" Transite pipe .90 22 50
3	Yds. Loam 3.50		10 50	1	Ton cold patch 8.00 8 00
20	Lbs. Grass seed 1.10		22 00	4	Ton hot top 7.45 29 80
3	Hrs. trucking 3.00		9 00	1	Yd. Loam 3 50
6	Hrs. shovel 6.50		39 00	5	Lbs. seed 1.10 5 38
1	Hr. Loader		4 00	1	Hr. truck 3 00
1	Hr. compressor		5 00	1	" " @ 1.50 75
			391 46	$\frac{1}{2}$	" Compressor 3.00 1 50
				$\frac{1}{2}$	" Roller 2.00 1 00
					Trailer 2 88
					231 56

DATE \_\_\_\_\_

TOWN OF LEXINGTON — BOARD OF PUBLIC WORKS  
**SEWER DIVISION**

Sketch of Service Here

35

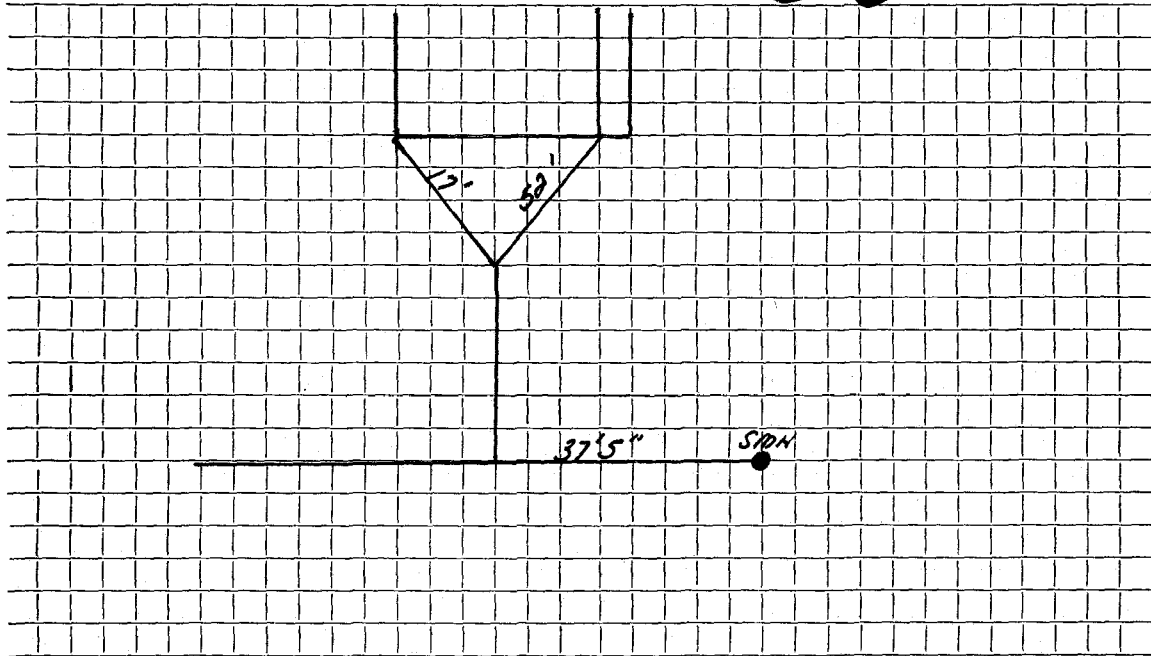

Connection made in ..... Street. Work completed .....

Remarks: .....

.....  
.....