

Name William B. Porter

Service No. 155

Address 37 Grant Street

Location

Kind of Pipe

Size

Size of Main

Repair—Renewal—New Service

Location

DEC 28 1964

XXXXXXXXXXXXXXXXXXXX W.O. #9231


Date	Material	Amount	Total	Date	Amount
10-28-64	Labor	83 09		7-11-64	275 00
	10% O.H.	8 31	91 40	12-28-64	156 48
	34' 6" Transite pipe @.82		27 88		118 52
	1 Bag Cement		1 50		
	1 6" Duplex Adapter		1 90		
	12 X 3 Patch		12 00		
	2 Yds. Loam @3.00		6 00		
	2 Sq. Concrete		27 50		
	(Broken on Sidewalk)				
	2 Hrs. Town Shovel @6.50		13 00		
	2 Hrs. Trucking @3.00		6 00		
			187 18		
	PRO-RATE				
	187.18 X 15.833/25 yrs. =		118 52		

DATE \_\_\_\_\_

TOWN OF LEXINGTON — BOARD OF PUBLIC WORKS

SEWER DIVISION

Sketch of Service Here

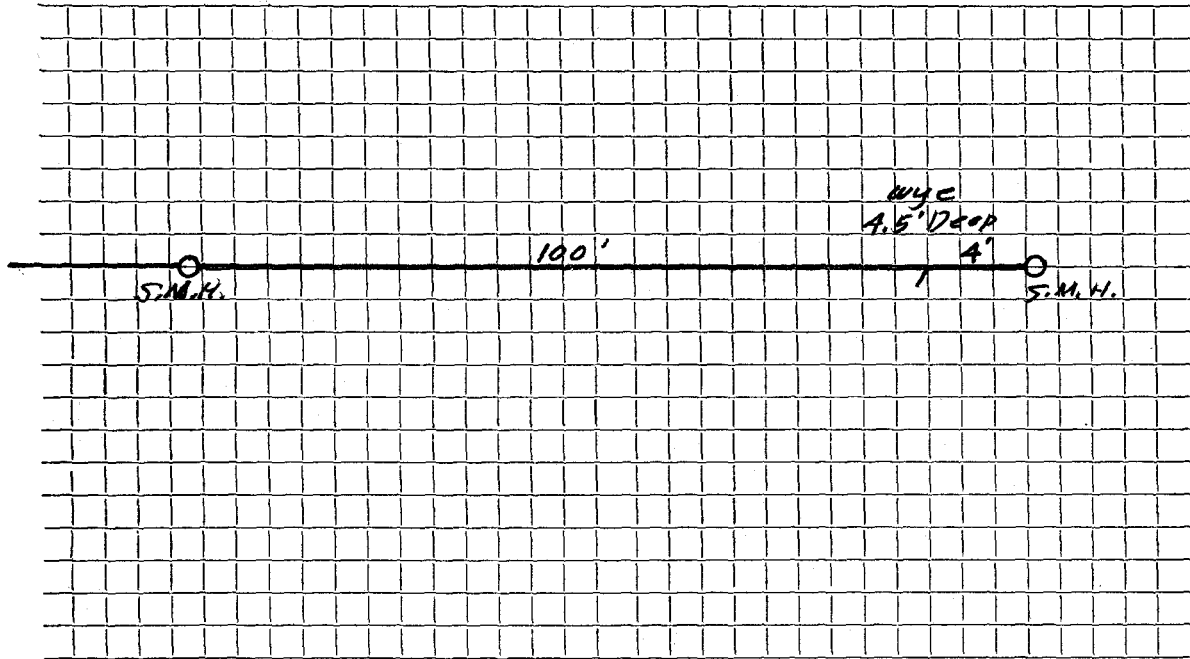

Connection made in ..... Street. Work completed .....

Remarks: Original Service 9-29-49 .....

.....  
.....