


DATE 8/13/19

TOWN OF LEXINGTON — BOARD OF PUBLIC WORKS
SEWER DIVISION

Sketch of Service Here

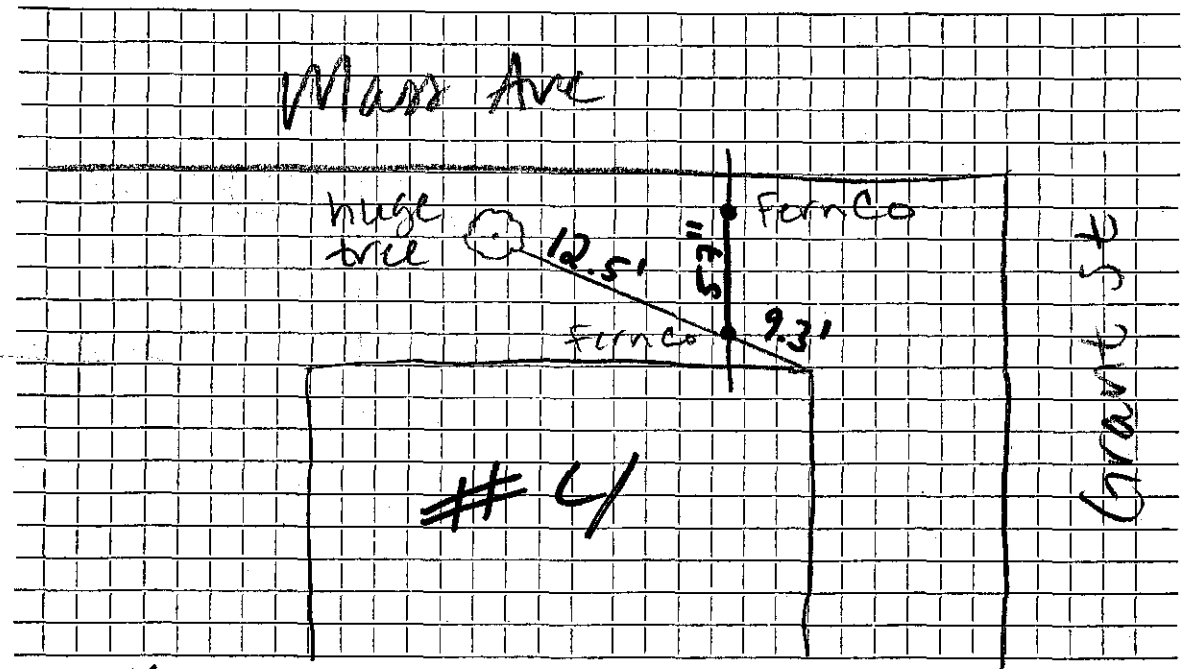

Connection made in Mass Ave Street. Work completed

Remarks: root blockage repaired → 5.7" repair