


DATE January 2018

TOWN OF LEXINGTON — BOARD OF PUBLIC WORKS
SEWER DIVISION

Sketch of Service Here

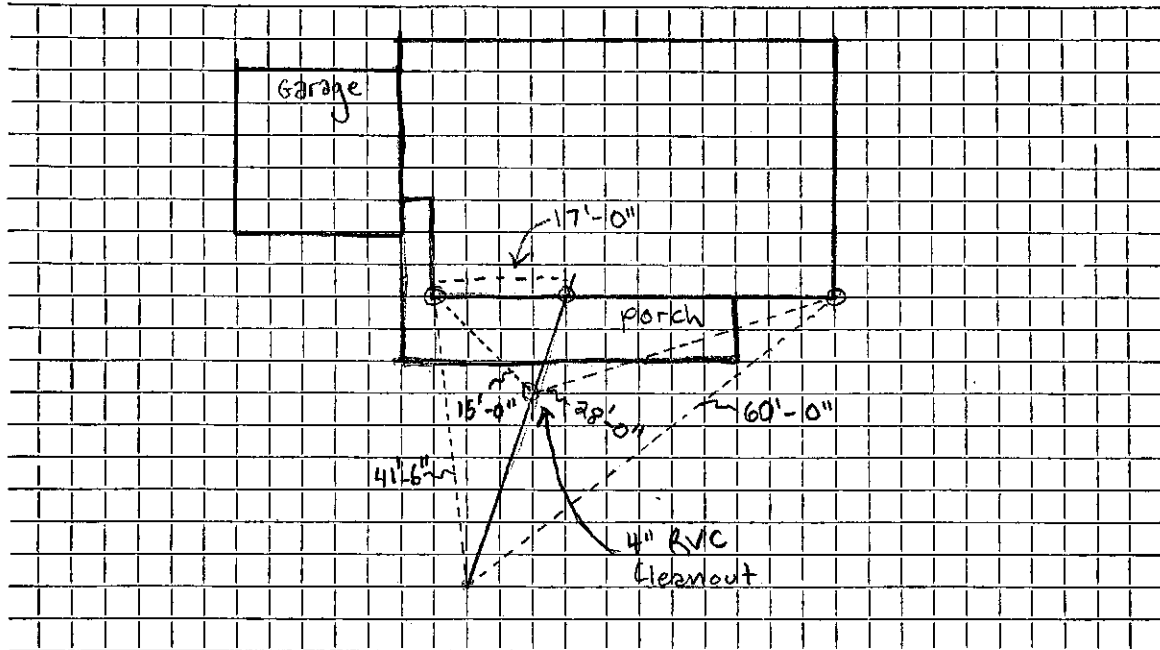

Connection made in 48 Grant Street Street. Work completed

Remarks: Total Sewer Length 46'-0"; Foundation → cleanout 7'-0", 6" RVC pipe 39'-0"