

Name William H. Sullivan

Service No. 74

Address 54 Grant Street

Location

Kind of Pipe

Size

Size of Main

~~Repair—Renewal—New Service~~ W.O. #7278 Sibley #1173

Location NOV 18 1968


Date	Material	Amount	Total	Date	Amount
8/27/68	Labor	103 68		2-22-68	245 00
9/5/68	"	26 97		11-18-68	53 63
	10% O.H.	13 07	143 72		211 37
	20' 6" transite pipe @ .88		17 60		
	1 6x8 saddle		5 50		
	1 6"x12" extension		1 21		
	1 90° elbow		4 09		
	1 Ton cold patch		5 50		
	2½ Hrs. trucking @ 3.00		7 50		
	½ " " @ 1.50		75		
	1 " compressor		5 00		
	1 " loader		4 00		
	2 " shovel @ 6.50		13 00		
	½ " roller @ 3.00		1 50		
	trailer		2 00		
8-28-68	35' 6" Transite pipe		211 37		
	10' 4" Cast Iron				

DATE _____

TOWN OF LEXINGTON — BOARD OF PUBLIC WORKS
SEWER DIVISION

Sketch of Service Here

54

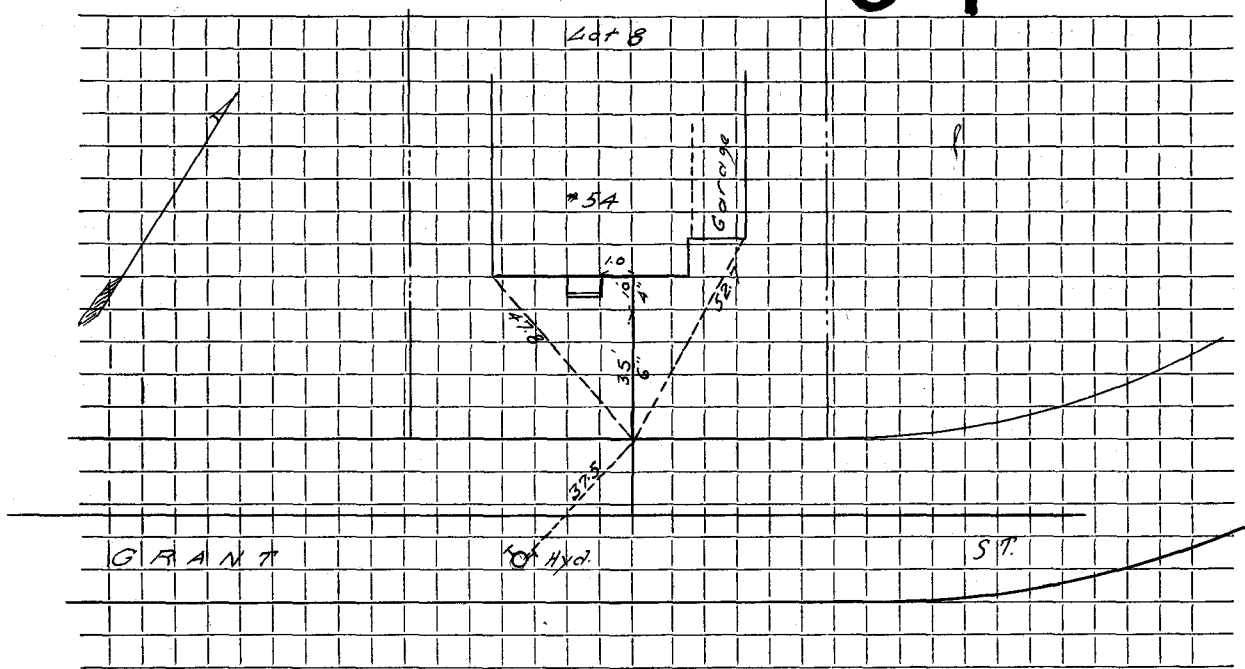

Connection made in Street. Work completed

Remarks:
.....
.....