


DATE 12/4/96

TOWN OF LEXINGTON — BOARD OF PUBLIC WORKS
SEWER DIVISION

Sketch of Service Here

67

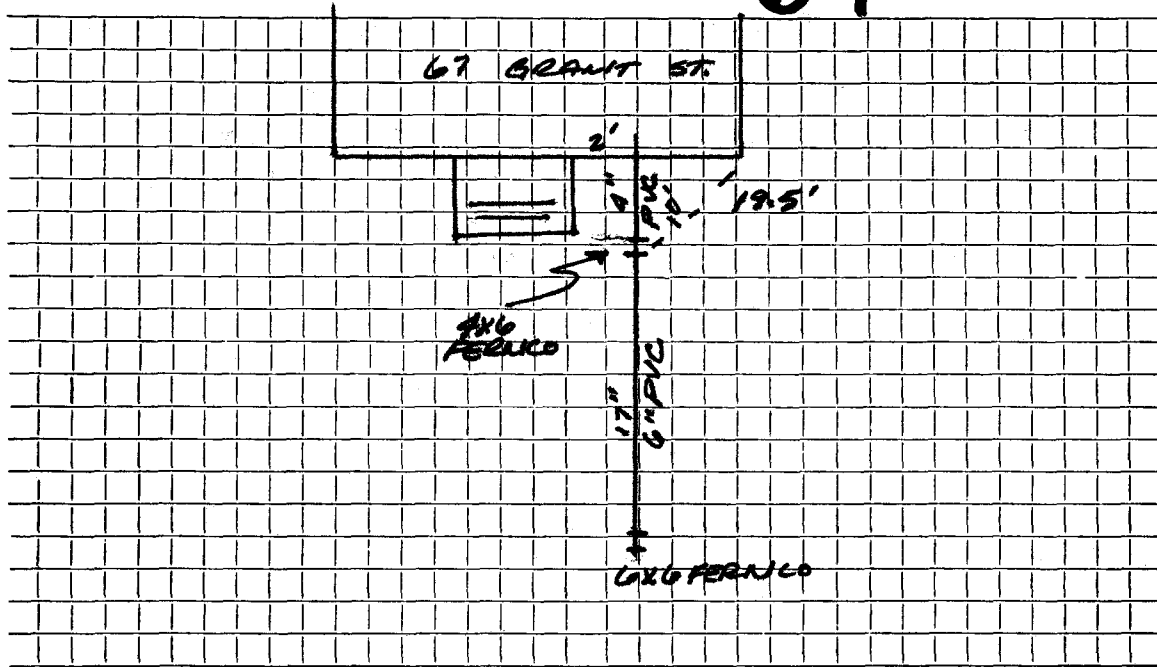

Connection made in ... GRANT STREET ... Street. Work completed ... ALEX OIL CORP.

Remarks: ORIGINAL Service 4-10-28.