




DATE \_\_\_\_\_

# TOWN OF LEXINGTON — BOARD OF PUBLIC WORKS

## SEWER DIVISION

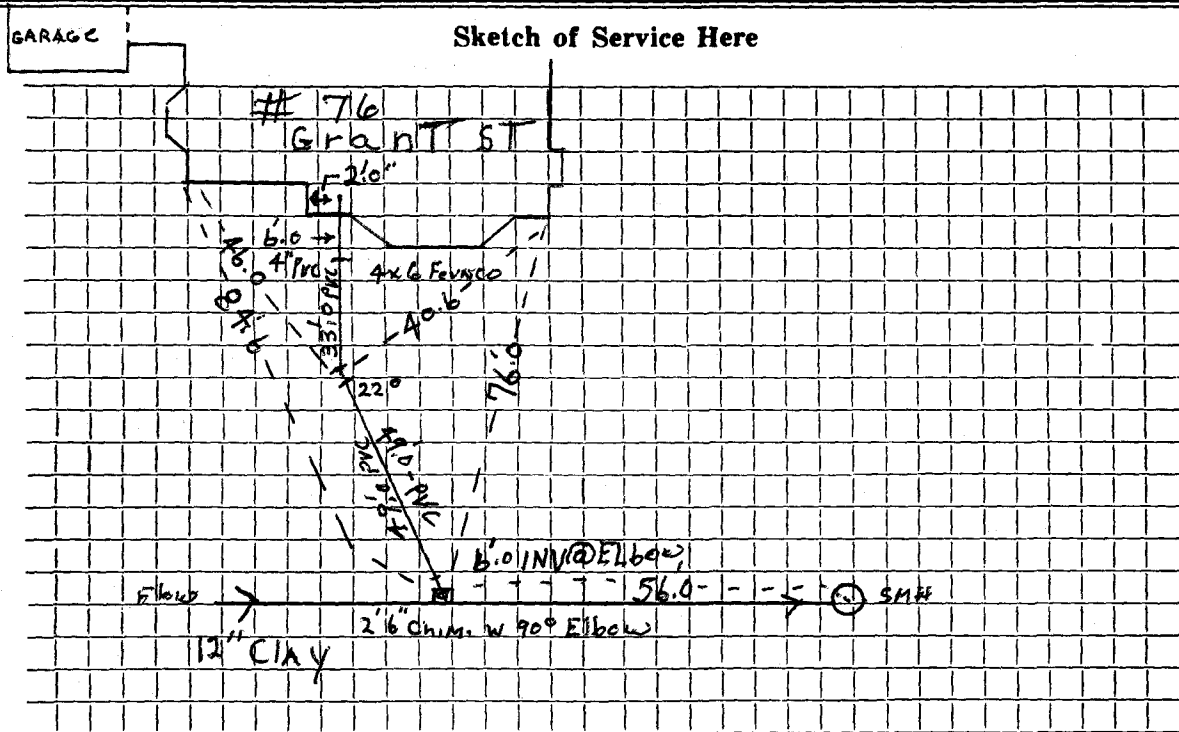

Connection made in Grant St Street.

Work completed Sept. 29, 2005 J. McLaughlin

Remarks: .....

.....

.....