




DATE \_\_\_\_\_

TOWN OF LEXINGTON — BOARD OF PUBLIC WORKS

SEWER DIVISION

Sketch of Service Here

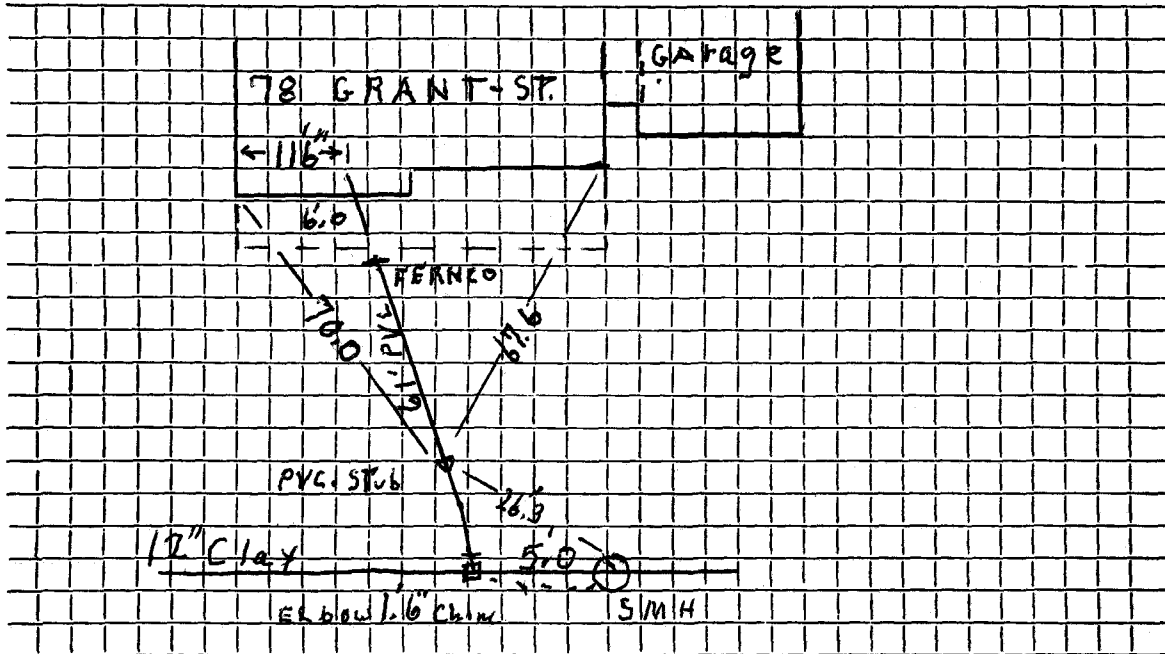

Connection made in ..... Street.

Work completed 1/28/06 J. McLaughlin.

Remarks: 6" PVC Tied into Existing PVC Stub, INST 9/29/05 J.M.