

Name Freeman C. Randall

Service No. 4310

Address

~~54 Fletcher Ave.~~

79 Grant St.

Location 79 Grant St.

Kind of Pipe

Size

Size of Main

~~PIPE SERVICE~~ New Service

Location

Date	Material	Amount	Total	Date	Amount
2-5-29 <i>for</i>	45' 6" Sewer Pipe @.30	13 50			
1-5-30	Sulphur & Jute	<u>1 80</u>	15 30	Dec. <sup>23</sup> 16	1930 - Abate 15 30
3/13/29	Labor on water bill				
				APR 10/16/29	
				A. R. 1-31-30	
				APR. 10-1-30	
	Labor				

Hadley Press, Inc., Lexington

TOWN OF LEXINGTON—BOARD OF PUBLIC WORKS

SEWER DIVISION

DATE 1/28/29

NO. \_\_\_\_\_


The undersigned applies for the construction of a particular sewer connecting No. Grant Street Street and hereby agrees to comply with the Rules and Regulations governing the construction and use of Particular Sewers, as now or at any future time established by the Board of Selectmen.

Am't. of Estimate \$ 42<sup>00</sup>

Am't. Paid \$ \_\_\_\_\_

Freeman C. Randeep Owner  
*FR*

Sketch of Service Here

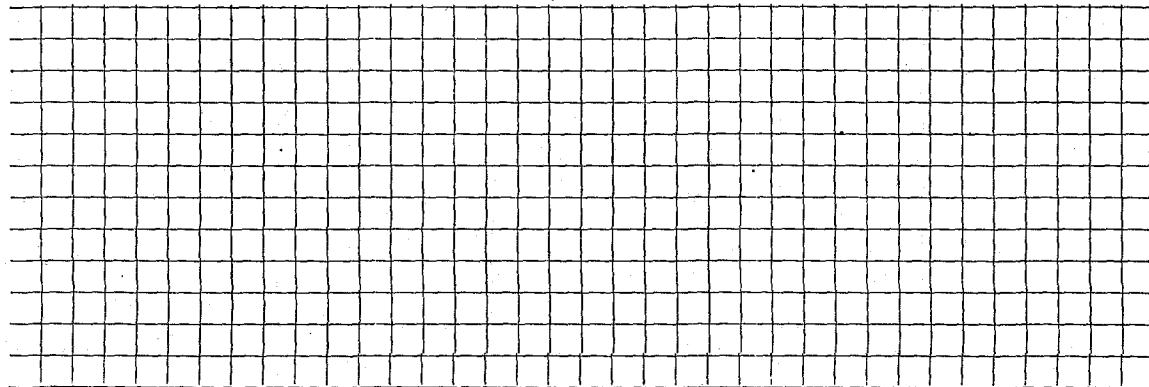

Connection made in \_\_\_\_\_ Street.

Work completed \_\_\_\_\_ 19

Remarks: