

Name Louis Portais

Service No. 1088 ³⁹

Address 83 Grant Street

Lexington, Mass.

Location 83 Grant Street

Kind of Pipe

Size

Size of Main

~~Repair~~ ~~Renewal~~ New Service

Location

Date	Material	Amount	Total	Date		Amount
Sept. 9, '47	Labor	42 47	42 47	Aug 27 '47	Deposited	90 00
	10% Overhead		4 25	Nov 29 '47	Refunded	8 42
	48' - 6" Sewer Pipe @ .26		12 48			81 58
	Joint Compound		2 88			
	Patching 17 x 3		17 00			
	Compressor 1 hr. @ 1.75		1 75			
	Trucking 1 hr. @ .75		75			
			81 58			
	Labor					
	Com 11-24-47					

TOWN OF LEXINGTON—DEPT. OF PUBLIC WORKS

SEWER DIVISION

DATE

NO.

The undersigned applies for the construction of a particular sewer connecting No. Street and hereby agrees to comply with the Rules and Regulations governing the construction and use of Particular Sewers, as now or at any future time established by the Board of Selectmen.


Am't of estimate \$.....

Am't Paid \$.....

*119 Lake St
Lexington, Mass*

..... Owner

Sketch of Service Here

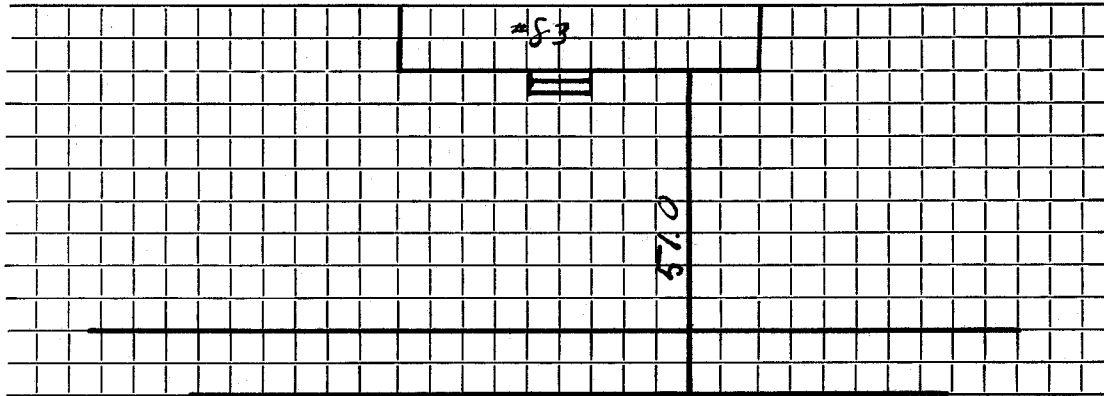

Connection made in Street.

Work completed 19..

Remarks: