

Name J.R.S. Holmes

Service No. 89

Address 10 Grapevine Avenue

## Location

Kind of Pipe 6" Transite

Size 6"

Size of Main

~~Repair - Renewal~~ New Service W.O.#2658 Ralph Surianello


Location FEB 10 1975

Date	Material	Amount	Total	Date	Amount
10-25-'74	Labor	132 65		10-21-74	385 00
	10% O.H.	13 27	\$145 92	3-12-75	13 91
30'	6" Transite Pipe @1.24		37 20		593 91
1	6 x 8 CI Saddle		13 96		
1	6 x 6 Nipple		1 76		
1	6" 90° Elbow		5 07		
3	Ton Gravel @2.25		6 75		
2½	Hrs. Town Shovel @6.50		16 25		
4½	Hrs. Trucking @3.00		13 50		
½	Hr. Roller @200		1 00		
½	Hr. Compressor @5.00		2 50		
4	Ton Hot Top @12.50		50 00		
			\$393.91		
11-11-74	50' 6" Transite				
	18' 4" Cast Iron				
				Bill sent 1391	

DATE \_\_\_\_\_

TOWN OF LEXINGTON — BOARD OF PUBLIC WORKS  
SEWER DIVISION

Sketch of Service Here **10**

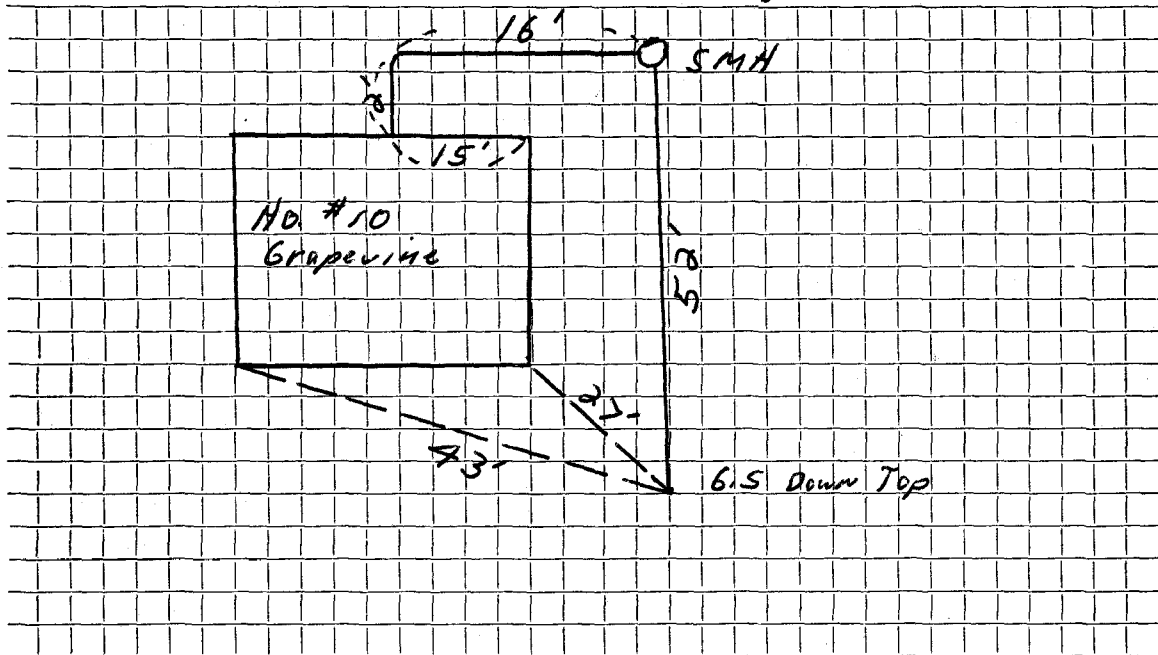

Connection made in Grapevine Street. Work completed .....

Remarks: .....  
.....  
.....