

Name E. Crouch

Service No. 7

Address 11 Grape Vine Avenue

Location 11 Grape Vine Avenue

Kind of Pipe

Size

Size of Main

~~Repair~~ ~~Removal~~ New Service

Com. 5/28/51

Location

Date	Material	Amount.	Total	Date	Amount
3/9/51	Labor	28 57	28 57	3/8/51	100 00
	10% Overhead		2 86	8/2/51	(19 41)
	44'-6" Sewer Pipe @ .344		15 14		80 59
	1-6" elbow		1 88		
	Joint Compound		2 64		
	4 Hrs. Littlefield Shovel		28 00		
	2 Hrs. Trucking		1 50		
			<del>55 47</del>		
			80 59		
	Labor				

# TOWN OF LEXINGTON—DEPT. OF PUBLIC WORKS

## SEWER DIVISION

DATE .....

NO. ....


The undersigned applies for the construction of a particular sewer connecting No. .... Street and hereby agrees to comply with the Rules and Regulations governing the construction and use of Particular Sewers, as now or at any future time established by the Board of Selectmen.

Am't of estimate \$.....

Am't Paid \$.....

..... Owner

Sketch of Service Here

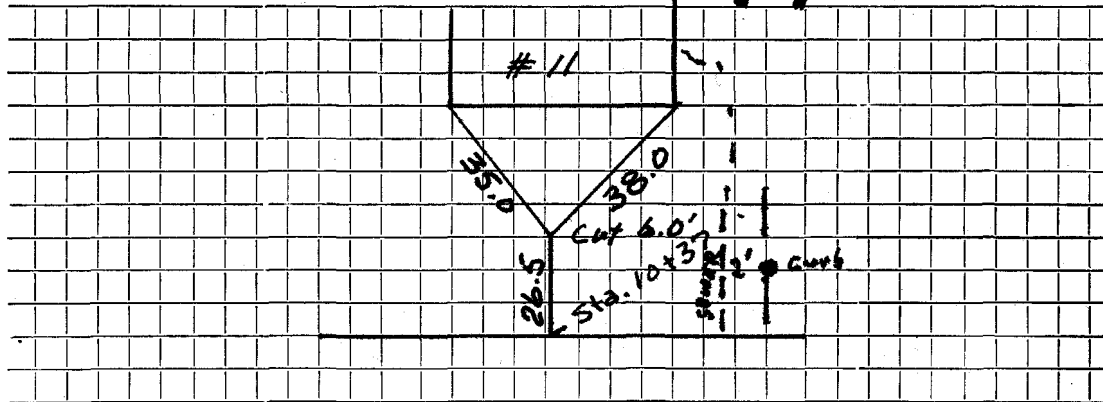

Connection made in ..... Street.

Work completed ..... 19..

Remarks: