

Name Corinne Petrino

Service No. 12

Address 18 Grapevine Ave.

Location

Lot 24

Kind of Pipe

Size

Size of Main

Repair—Renewal—New Service DeFlice #985

Location



Date

Material

Amount

Total

Date

Amo

~~22' 6" V.P. @ 3.00~~

66 00

4-3-68

Deposit

66 00

Installed by contractor

Bill owner when connected

4-3-68

4-16-68

34'

6" Transite pipe

22' 6" Transite

10'

4" Cast Iron pipe

Labor

TOWN OF LEXINGTON—DEPT. OF PUBLIC WORKS

SEWER DIVISION

DATE.....

NO.


The undersigned applies for the construction of a particular sewer connecting No..... Street and hereby agrees to comply with the Rules and Regulations governing the construction and use of Particular Sewers, as now or at any future time established by the Board of Selectmen.

Am't of estimate \$.....

Am't Paid \$.....

..... Owner

Sketch of Service Here

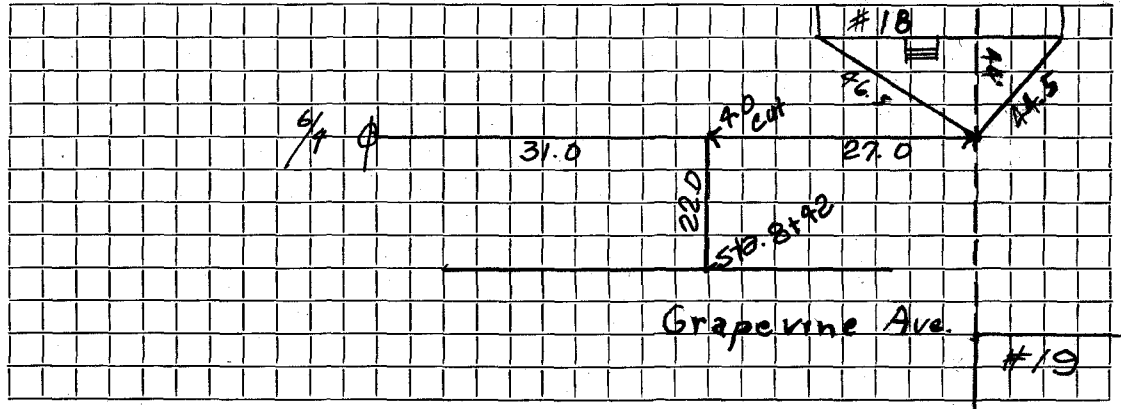

Connection made in..... Street.

Work completed.....19..

Remarks: