

Name Esco Builders Corp.

Service No. 207

Address 20 Grapevine Ave.

Location Lot 25

Kind of Pipe

Size

Size of Main

~~REPAIR/RENEWAL~~ New Service No 7749

Location Comm 1-14-63

Date	Material	Amount	Total	Date	Amount
	25' 6" V.P. @ 3.00		75.00	11-28-62	Deposit 175.00
	Installed by contractor			1-14-63	Refund 35.64
	Bill owner when connected				139.36
12-3-62	Labor	26.73			
	10% O.H.	2.67	29.40		
	37' 6" Transite Pipe @.82		30.34		
	1 6" Duplex Adapter		1.62		
	1 hr Trucking @3.00		<u>3.00</u>		
			139.36		
	Labor				

TOWN OF LEXINGTON—DEPT. OF PUBLIC WORKS

SEWER DIVISION

DATE.....

NO.


The undersigned applies for the construction of a particular sewer connecting No.....
 Street and hereby agrees to comply with the Rules and Regulations governing the construction and use of Particular
 Sewers, as now or at any future time established by the Board of Selectmen.

Am't of estimate \$.....

Am't Paid \$.....

..... Owner

Sketch of Service Here

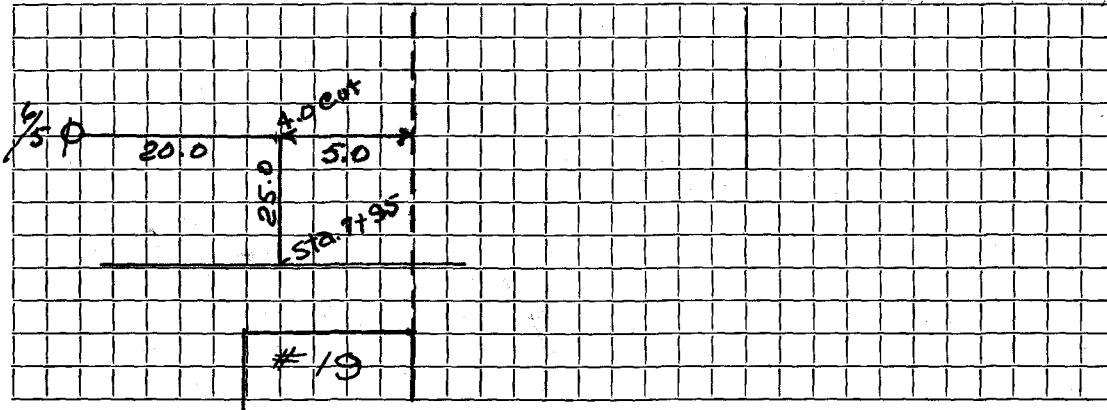

Connection made in..... Street.

Work completed.....19..

Remarks: