

Name **Esco Builders Corporation**

Service No. **9**

Address **22 Grapevine Ave.**

Location **Lot # 26**

Kind of Pipe

Size

Size of Main

Repair—Renewal—New Service

Location **Comm 4-22-63**

Date	Material	Amount	Total	Date		Amount
	22' 6" V.P. @ 3.00		66 00	3-29-63	Deposit	175 00
	Installed by contractor			4-22-63	Refund	54 62
	Bill owner when connected					120 38
4/10/63	Labor	16 89				
	10% O.H.	1 69	18 58			
	40' 6" Transite Pipe @ .82		32 80			
	1 Hr. Trucking @ 3.00		3 00			
			120 38			
				9/21/87	obstruction 60' OUT Johns Sewer	
					<input checked="" type="checkbox"/> RESPOND + MEASURE	
	Labor					

# TOWN OF LEXINGTON—DEPT. OF PUBLIC WORKS

## SEWER DIVISION

DATE.....

NO. ....


The undersigned applies for the construction of a particular sewer connecting No.....  
 Street and hereby agrees to comply with the Rules and Regulations governing the construction and use of Particular  
 Sewers, as now or at any future time established by the Board of Selectmen.

Am't of estimate \$.....

Am't Paid \$.....

..... Owner

Sketch of Service Here

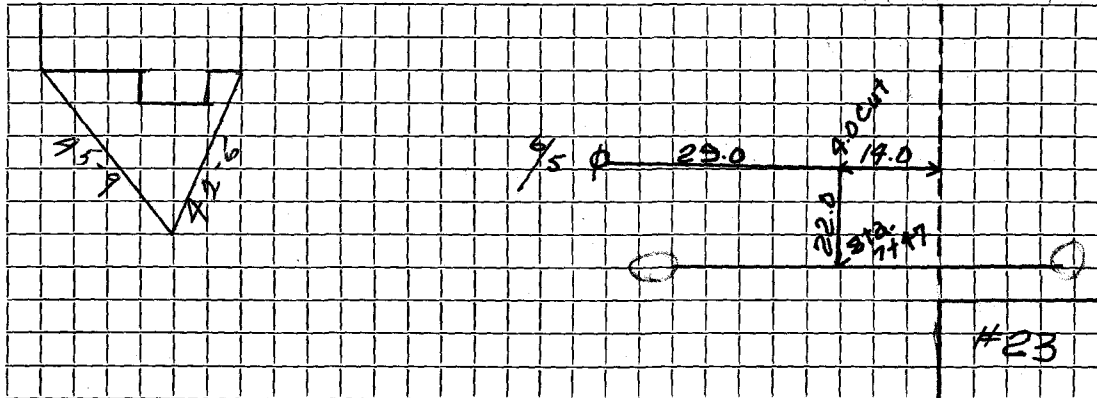

Connection made in..... Street.

Work completed.....19..

Remarks: