

Name **Esco Builders Corp.**

Service No. **41**

Address **24 Grapevine Ave.**

Location **Lot #27**

Kind of Pipe

Size

Size of Main

~~XXXXXXXXXXXX~~ - New Service **W 0 7912**

Location **Comm 6-3-63**

Date	Material	Amount	Total	Date	Amount
	21ft. 6" V.P. @	3.00	63.00	5-10-63	Deposit 135.00
	Installed by contractor			6-3-63	Refund 8.92
	Bill owner when connected				126.08
5-16-63	Labor	32.25			
	10% O.H.	3.23	35.48		
	30' 6" Transite pipe @.82		24.60		
	1 hr. Trucking @3.00		<u>3.00</u>		
			126.08		
	Labor			9-6-88	Block Service Incorrect Elevation
				12-21-93	S.B. 18'-20' out
				1-7-92	S.B.
				2-21-92	" "

TOWN OF LEXINGTON—DEPT. OF PUBLIC WORKS

SEWER DIVISION

DATE.....

NO.


The undersigned applies for the construction of a particular sewer connecting No..... Street and hereby agrees to comply with the Rules and Regulations governing the construction and use of Particular Sewers, as now or at any future time established by the Board of Selectmen.

Am't of estimate \$.....

Am't Paid \$.....

..... Owner

Sketch of Service Here

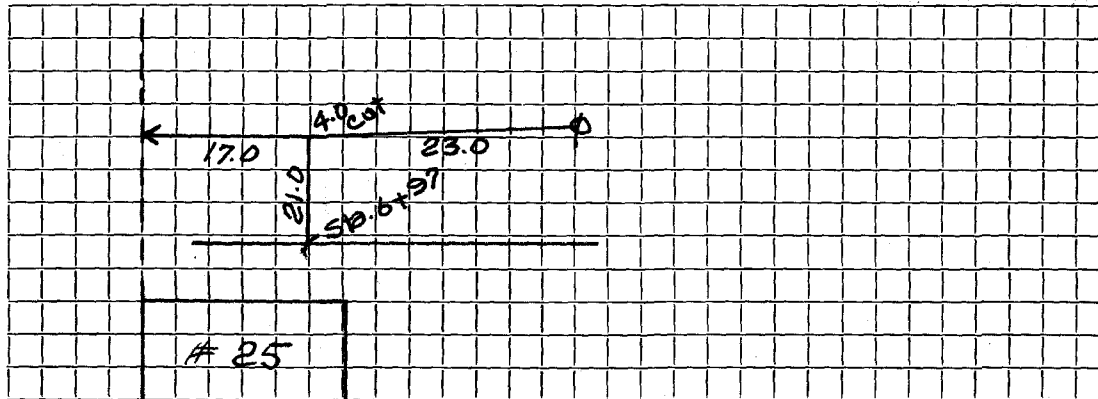

Connection made in..... Street.

Work completed.....19..

Remarks: