

Name Esco Builders Corp.

Service No. 224

Address 28 Grapevine Ave.

Lot 28

Location

Kind of Pipe

Size

Size of Main

~~Repair/ Renewal~~ - New Service

WO # 7769

Location Comm 3-25-63

Date	Material	Amount	Total	Date	Amount
	24 ft. 6" V.P. @ 3.00		72 00	12-12-62	175 00
	Installed by contractor			4-1-63	7 62
	Bill owner when connected				<u>182 62</u>
12-20-62	Labor	48 53		12-12-62	
	10% O.H.	4 85	53 38	24' 6" Transite	
	40' 6" Transite pipe @.82		32 80	5-30-78	Repair
	1 1 1/4" Transite Bend		4 09		1 6"-33 1/3" Bend
	20 1/2 ton Fill @.70		14 35		1 6"x5' Nipple
	2 hrs. Trucking @3.00		6 00		1 6"x12" Nipple
			<u>182.62</u>		1 6"x6" Nipple
				4-11-74	Solids 51' out
	Labor			11-21-75	Solids
				5-20-95	Roots + Paper 24' out
				8-26-98	D.T.C.

TOWN OF LEXINGTON—DEPT. OF PUBLIC WORKS

SEWER DIVISION

DATE.....

NO.


The undersigned applies for the construction of a particular sewer connecting No..... Street and hereby agrees to comply with the Rules and Regulations governing the construction and use of Particular Sewers, as now or at any future time established by the Board of Selectmen.

Am't of estimate \$.....

Am't Paid \$.....

..... Owner

Sketch of Service Here

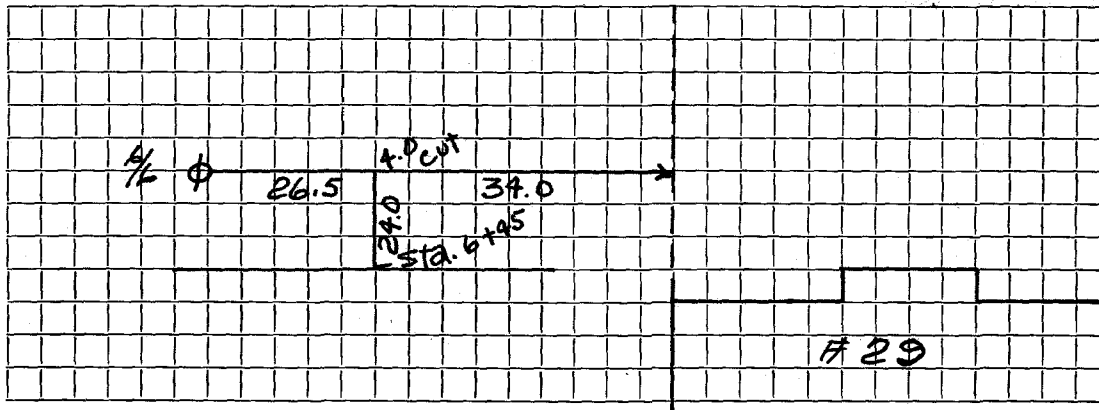

Connection made in..... Street.

Work completed.....19..

Remarks: