

Name Camille J. TremblayService No. 65Address 29 Grapevine AvenueLot # 71LexingtonLocation 29 Grapevine Avenue

Kind of Pipe

Size

Size of Main

~~Repair-Renewal~~ New ServiceCom. 11-6-50

Location

Date	Material	Amount	Total	Date	Amount
Sept. 13 '50	Labor	32 70			
" 14 "	" "	10 60		Aug. 23 '50 <u>Dis-jointed</u>	85 00
	10% Overhead	4 33	47 63	Nov. 28 '50 <u>Work</u>	5 85
	52' - 6" Sewer Pipe		14 56		90 85
	2 - 6" - 1/8 Bends		3 04		
	Joint Compound		3 12	<u>Bill sent 11-15-50</u>	
	3 hrs. Littlefield Shovel		21 00		
	2 hrs. Trucking		1 50		
			90 85		
	Labor			9-28-50	<u>Roots 25' - 40' out</u>

TOWN OF LEXINGTON—DEPT. OF PUBLIC WORKS  
**SEWER DIVISION**

DATE .....

NO. ....

The undersigned applies for the construction of a particular sewer connecting No. ....  
Street and hereby agrees to comply with the Rules and Regulations governing the construction and use of Particular  
Sewers, as now or at any future time established by the Board of Selectmen.

Am't of estimate \$. ....


Am't Paid \$. ....

..... Owner

7-1-98

Sketch of Service Here

REPAIR IN STREET  
2 FT PVC  
2 FT down

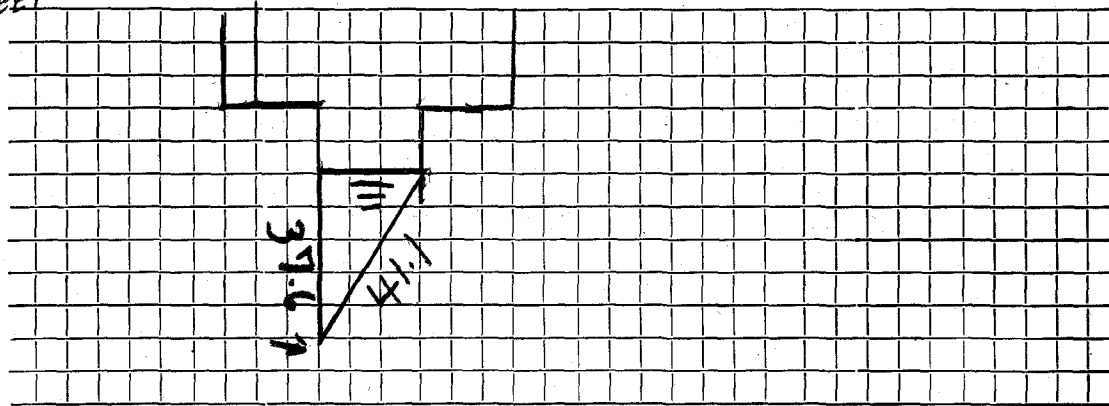

Connection made in ..... Street.

Work completed ..... 19..

Remarks: