

Name Esco Builders

Service No. 127

Address 30 Grapevine Ave.

Location Lot 29

Kind of Pipe

Size

Size of Main

~~Repairs~~ New Service W.O.#8222

Location Comm 2-10-64

Date	Material	Amount	Total	Date	Amount
	25 ft 6" V.P. @ 3.00	75 00		10-2-63 2-10-64	Deposit 175 00
	Installed by contractor				Refund 15 40
	Bill owner when connected				159 60
10/7/63	Labor	36 97		9-27-77	
	10% O.H.	3 70	40 67		10' 6" Transite
	37' 6" Transite Pipe @ .82		30 34		1 6"-90° Elbow
	1 1 1/4" Transite Bend		4 09		1 6"X6" Nipple
	1 Hr. Town Shovel @ 6.50		6 50		1 6"X12" Nipple
	1 Hr. Trucking @ 3.00		3 00		1 6"X5' Nipple
			159 60		1 6"X2' Nipple
					1 6"-1 1/4" Bend
					1 6"-30° Bend
	Labor			9/10/69	Soop & debris
				10-28-78	Solids

TOWN OF LEXINGTON—DEPT. OF PUBLIC WORKS
SEWER DIVISION

DATE.....

NO.


The undersigned applies for the construction of a particular sewer connecting No.....
Street and hereby agrees to comply with the Rules and Regulations governing the construction and use of Particular
Sewers, as now or at any future time established by the Board of Selectmen.

Am't of estimate \$.....

Am't Paid \$.....

..... Owner

Sketch of Service Here

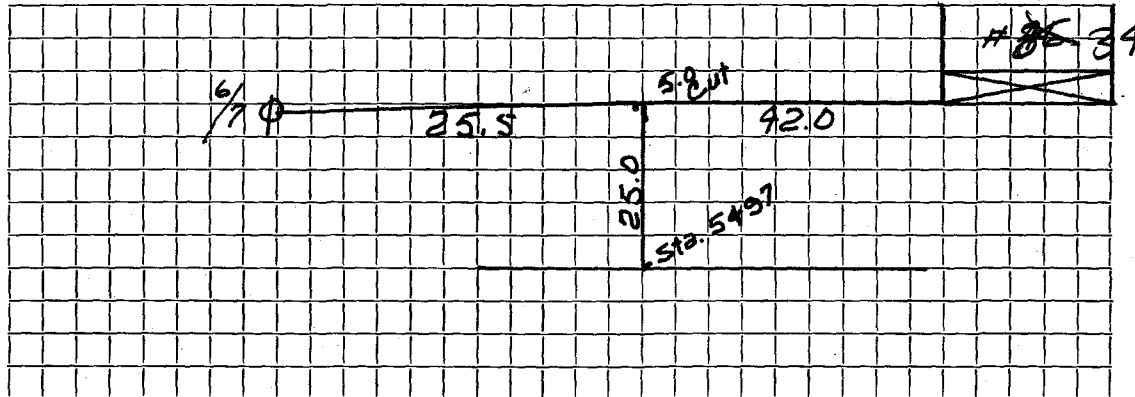

Connection made in..... Street.

Work completed.....19..

Remarks: