

Name **Guy Franceschelli**

Service No. **80**

Address **34 Grapevine Avenue**

*Lot # 30*

**Lexington**

Location **34 Grapevine Avenue**

Kind of Pipe

Size

Size of Main

~~Repair~~ ~~Renewal~~ **New Service**

*Con. 11-6-50*

Location

Date		Material	Amount		Total		Date	Amount
Sept. 14	'50	Labor	30	03			<i>Sept. 13 '50 Reprinted</i>	75
		10% Overhead	3	00	33	03	<i>Nov. 28 '50 6 and</i>	4 17
		40' - 6" Sewer Pipe			11	20		79 17
		2 - 6" - 1/8 Bends			3	04		
		Joint Compound			2	40	<i>Bill sent 11-15-50</i>	
		4 hrs. Littlefield Shovel			28	00	<i>checked 4-22-92</i>	
		2 hrs. Trucking			1	50	<i>3-1-68</i>	
					79	17		
							<i>2/19 68 Solids</i>	
		Labor					<i>4-4-73 Solids</i>	
							<i>5-3-74 Plugged Sewer</i>	
							<i>Solids; Iron Pipe Going Wrong Way</i>	

**TOWN OF LEXINGTON—DEPT. OF PUBLIC WORKS**  
**SEWER DIVISION**

DATE .....

NO. ....

The undersigned applies for the construction of a particular sewer connecting No. ....  
Street and hereby agrees to comply with the Rules and Regulations governing the construction and use of Particular  
Sewers, as now or at any future time established by the Board of Selectmen.


Am't of estimate \$. ....

Am't Paid \$. ....

..... Owner

---

**Sketch of Service Here**

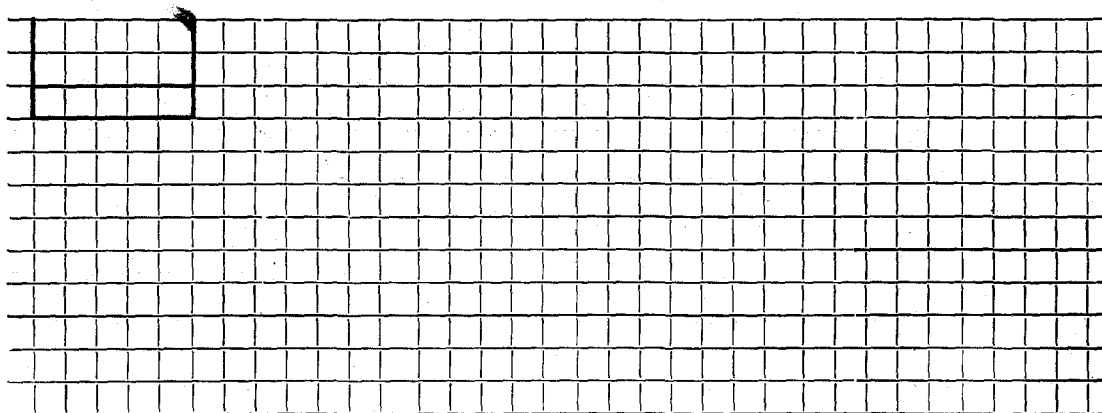

Connection made in ..... Street.

Work completed ..... 19..

Remarks: