

Name Donald Cruwys

Service No. 120

Address 36 Grapevine Ave.

Location Lot # 31

Kind of Pipe

Size

Size of Main

Repair—Renewal—New Service Russell Sibley Permit #423

Location SEP 27 1965

Date		Material	Amount	Total		Date		Amount
		27 ft 6" V.C pipe @ 3.00		81	00	8-4-65	Deposit	81 00
		Installed by contractor						
		Bill owner when connected				8-4-65		
						27'	6" Transite	
8-16-65	41'	6" Transite pipe						
		Labor						

TOWN OF LEXINGTON—DEPT. OF PUBLIC WORKS
SEWER DIVISION

DATE.....

NO.


The undersigned applies for the construction of a particular sewer connecting No.....
 Street and hereby agrees to comply with the Rules and Regulations governing the construction and use of Particular
 Sewers, as now or at any future time established by the Board of Selectmen.

Am't of estimate \$.....

Am't Paid \$.....

..... Owner

Sketch of Service Here

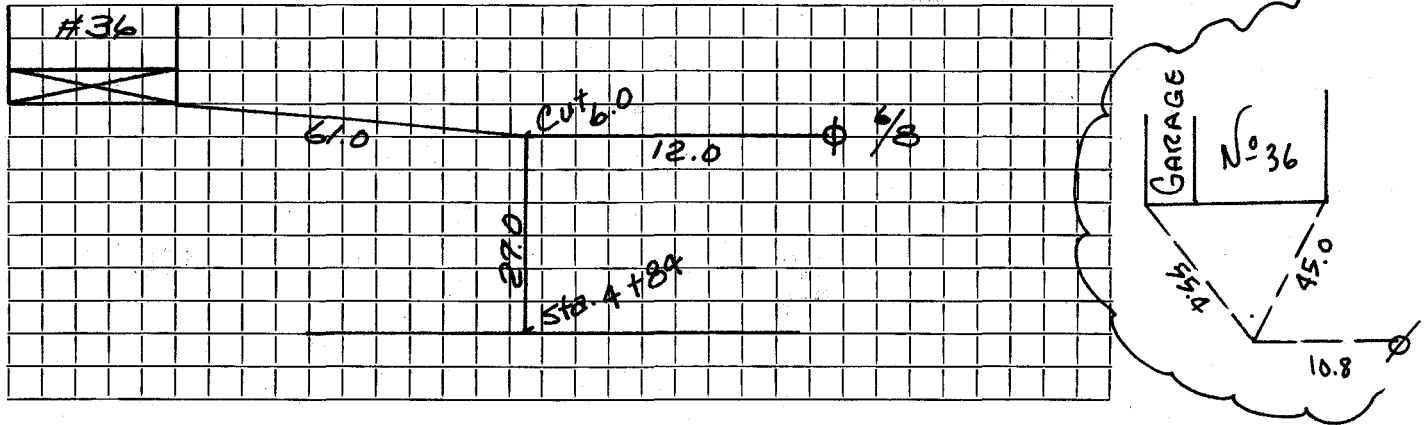

Connection made in..... Street.

Work completed.....19..

Remarks: