

Name Donald Cruwys

Service No. 121

Address ~~28~~³⁸ Grapevine Ave.

Location Lot 32

Kind of Pipe Permit #424

Size

Size of Main

~~Repair/Replace~~ New Service Russell Sibley

Location

DEC 31 1965

Date		Material	Amount	Total	Date	Amount
		25 ft. V.C. pipe @ 3.00		75 00	8-4-65	35 00
		Installed by contractor				
		Bill owner when connected			8-4-65	
11-3-65	43'	6" Transite pipe			25'	6" Transite
		Labor				

TOWN OF LEXINGTON—DEPT. OF PUBLIC WORKS
SEWER DIVISION

DATE.....

NO.


The undersigned applies for the construction of a particular sewer connecting No.....
 Street and hereby agrees to comply with the Rules and Regulations governing the construction and use of Particular
 Sewers, as now or at any future time established by the Board of Selectmen.

Am't of estimate \$.....

Am't Paid \$.....

..... Owner

Sketch of Service Here **38**

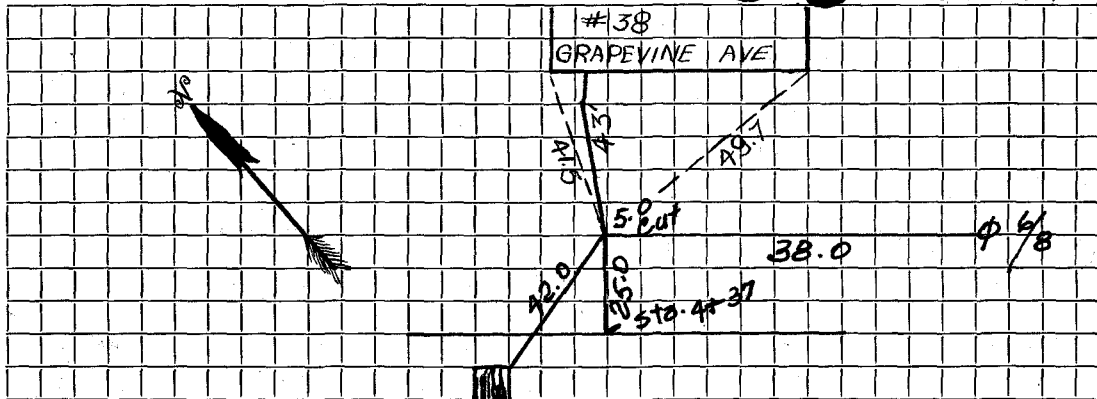

Connection made in Street.

Work completed.....19..

Remarks: