

Name Donald L. Cruwys

Service No. 234

Address 42 Grapevine Ave.

Location Lot 34

Kind of Pipe Russell Sibley

Size

Size of Main

~~Repair/Replace~~ New Service Permit #A 95

Location

MAR 14 1966

Date		Material	Amount	Total		Date		Amount
		21 ft. V.C. pipe 6" @ 3.00		63	00	11-16-65	Deposit	63 00
		Installed by contractor						
		Bill owner when connected				11-16-65		
12-7-65	37'	6" Transite pipe					21' 6" Transite	
		Labor						

TOWN OF LEXINGTON—DEPT. OF PUBLIC WORKS

SEWER DIVISION

DATE.....

NO.

The undersigned applies for the construction of a particular sewer connecting No..... Street and hereby agrees to comply with the Rules and Regulations governing the construction and use of Particular Sewers, as now or at any future time established by the Board of Selectmen.

Am't of estimate \$.....


Am't Paid \$.....

..... Owner

Sketch of Service Here

42

SS. For 1 of 24

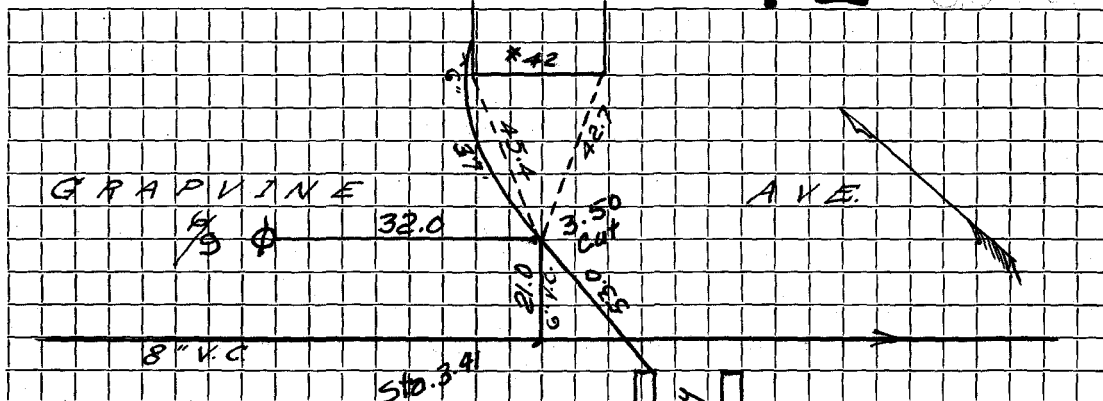

Connection made in..... Street. Well Drive way Well Work completed.....19..

Remarks: