

Name **Esco Builders**Service No. **219**Address **94 Grapevine Ave.**Location **Lot 35**

Kind of Pipe

Size

Size of Main

Repair—Renewal—New Service **WO # 8382**Location **MAR 23 1964**

Date	Material	Amount	Total	Date	Amount
	18 ft. 6" V.C. pipe @ 3.00		54 00	12-9-63	150 00
	Installed by contractor			3-23-64	45 23
	Bill owner when connected				104 77
12-17-63	Labor	17 34		12-9-63	
	10% O.H.	1 73	19 07	18' 6" Transite	
	35' 6" Transite Pipe @ .82		28 70		
	1 Hr. Trucking @ 3.00		3 00		
12-5-67			104 77		
	30' Pipe				
	Labor				

TOWN OF LEXINGTON—DEPT. OF PUBLIC WORKS

SEWER DIVISION

DATE.....

NO.

The undersigned applies for the construction of a particular sewer connecting No.....
 Street and hereby agrees to comply with the Rules and Regulations governing the construction and use of Particular
 Sewers, as now or at any future time established by the Board of Selectmen.


Am't of estimate \$.....

Am't Paid \$.....

..... Owner

Sketch of Service Here

SS. For 30' R/S

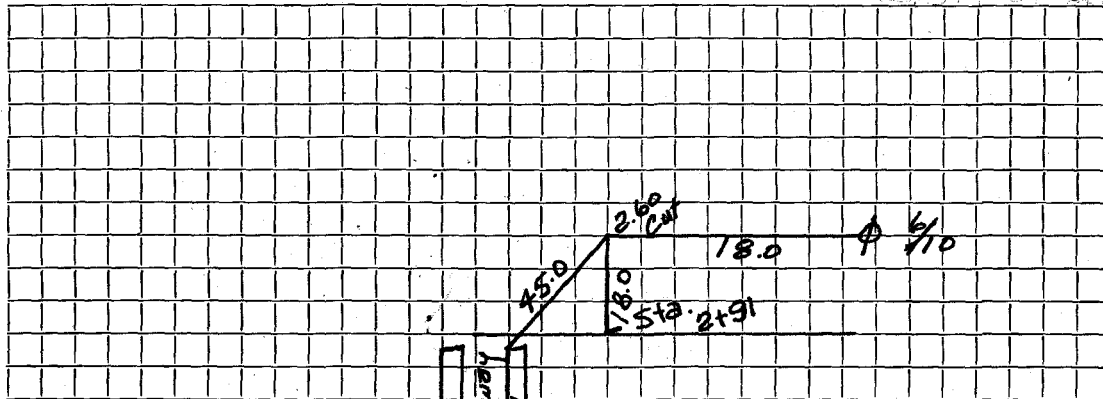

Connection made in..... Street.

Work completed.....19..

Remarks: