


DATE _____

TOWN OF LEXINGTON — BOARD OF PUBLIC WORKS
SEWER DIVISION

Sketch of Service Here

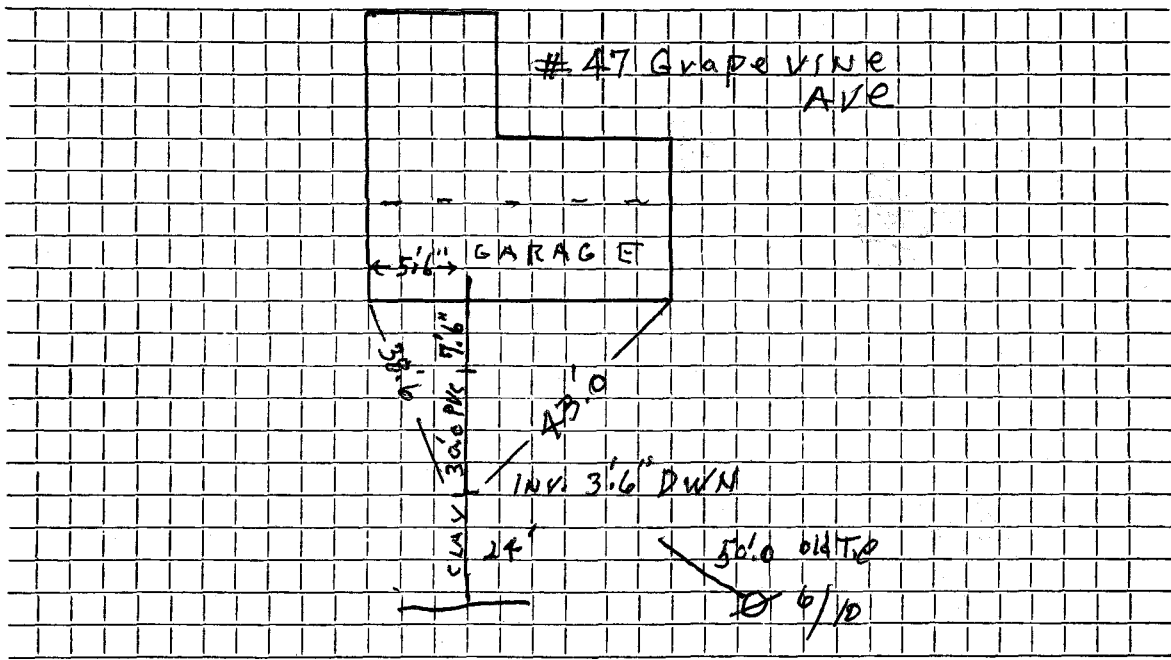

Connection made in Street.

Work completed 4/6/05 J. McLaughlin

Remarks: Old sand shower 24' A.C. 6"