

Name

Service No. 1648

Address

49 Grapevine Ave

Location

Kind of Pipe PVC

Size 6"

Size of Main

Repair—Renewal—New Service

Teardown & Melsing h/w


Location

Date	Material	Amount	Total	Date	Amount
12/5/04	4" Sch 40 PVC 40' 6" PVC				
1	4x6 Fernco				
1	6" Clay X PVC Fernco				
	Inso 3' 6" Duct				
1/18/51	EXIST 54 Clay				
1	6" Elbow JOINT Compound				

DATE \_\_\_\_\_

TOWN OF LEXINGTON — BOARD OF PUBLIC WORKS  
SEWER DIVISION

Sketch of Service Here

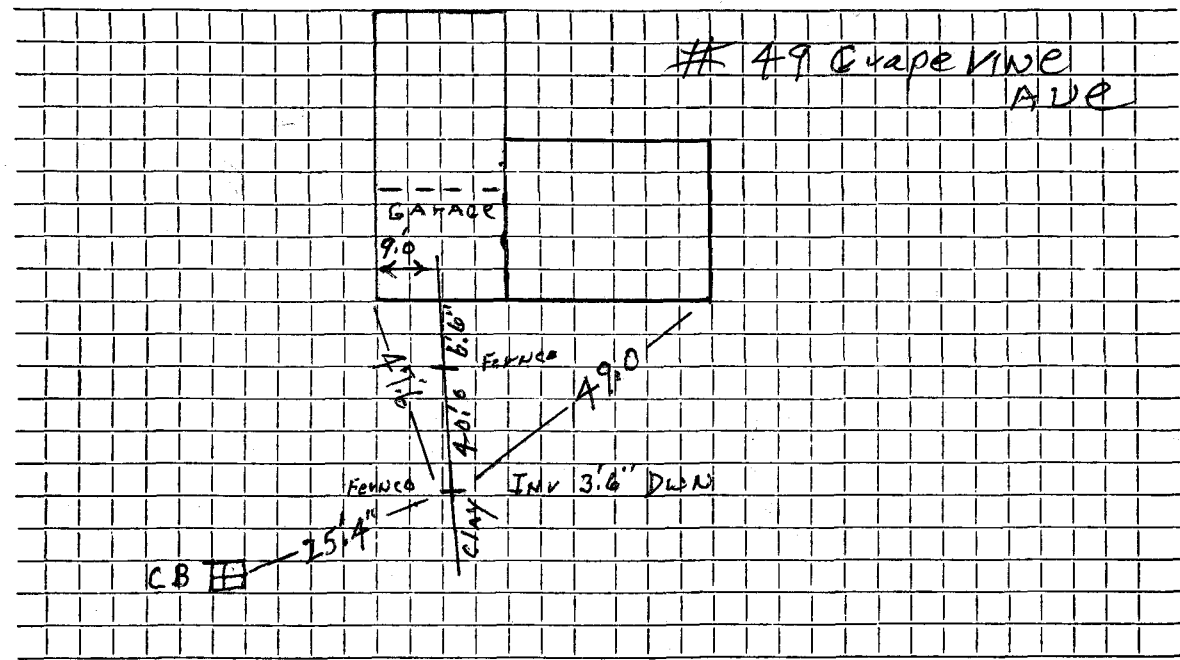

Connection made in ..... Street. Work completed 12/5/04 J. McLaughlin

Remarks: .....  
.....  
.....