

Name George W. Ewing

Service No. 127

Address 56 Grape Vine Avenue

Lot 39 39

Lexington, Mass.

Location

Kind of Pipe

Size

Size of Main

~~XXXXXXXXXXXX~~
Repair - Renewal - New Service

com. 12-31-51

Location

Date	Material	Amount	Total	Date	Amount
11/19/51	Labor	25 60		9-17-51	Deposited 125 00
	10% overhead	2 56	28 16	12-31-51	Refunded (38 58)
	64' - 6" sewer pipe @ .342		21 88		56 42
	1 - 6" elbow		1 88		
	1 - 6x6 Tee		1 16		
	joint compound		3 84		
	4 hrs. Littlefield shovel	7.00	28 00		
	2 hrs. trucking @ .75		1 50		
			86 42		
	Labor				

TOWN OF LEXINGTON—DEPT. OF PUBLIC WORKS
SEWER DIVISION

DATE

NO.

The undersigned applies for the construction of a particular sewer connecting No.
Street and hereby agrees to comply with the Rules and Regulations governing the construction and use of Particular
Sewers, as now or at any future time established by the Board of Selectmen.


Am't of estimate \$.

Am't Paid \$.

..... Owner

Sketch of Service Here

56

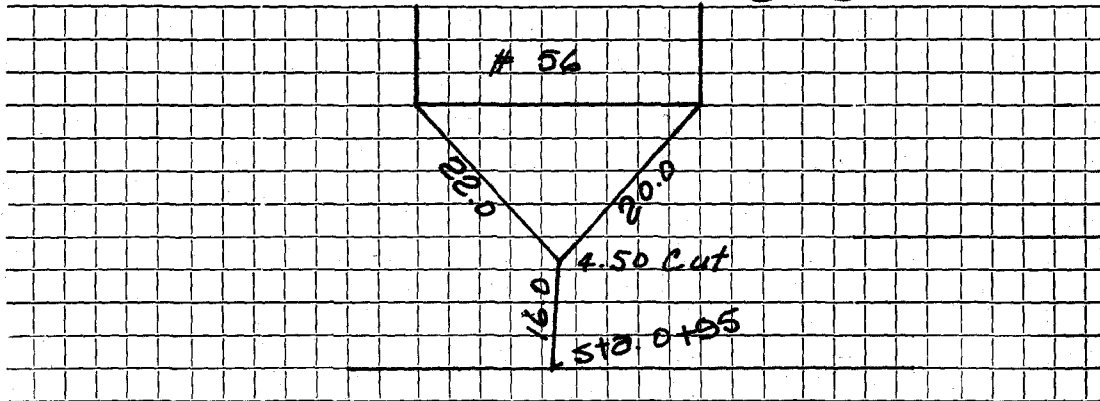

Connection made in Street.

Work completed 19..

Remarks: