


DATE 9/12/89

TOWN OF LEXINGTON — BOARD OF PUBLIC WORKS

SEWER DIVISION

Sketch of Service Here

57

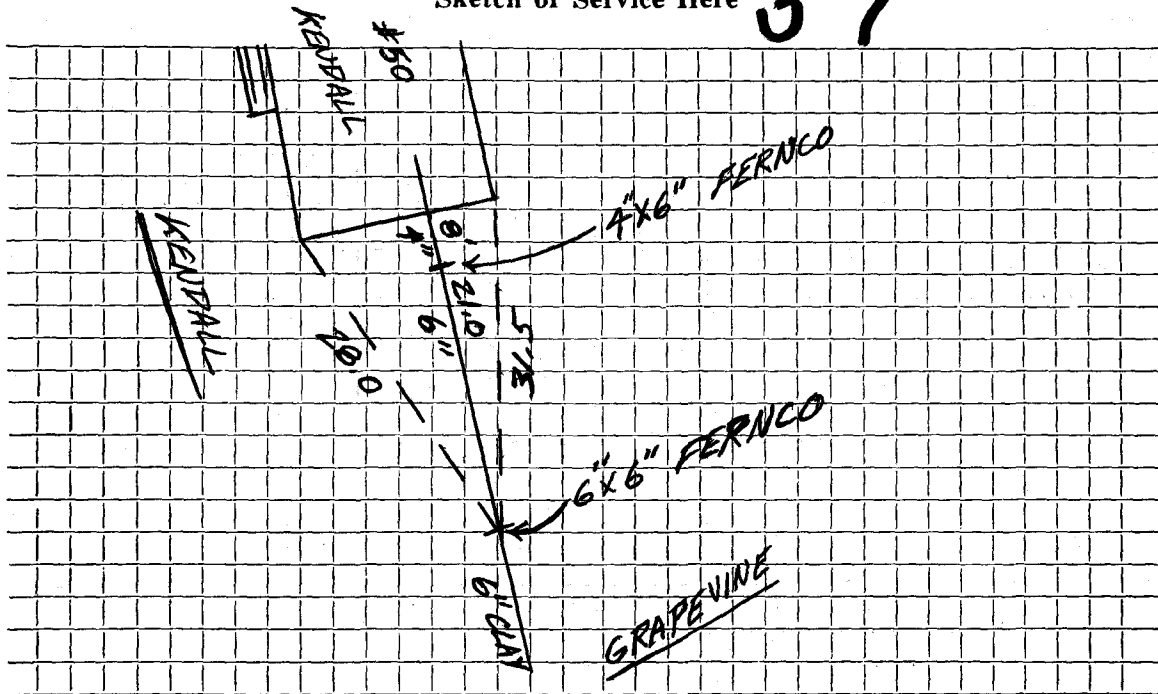

Connection made in Street. Work completed

Remarks: INS.P. CRG.