

Name John R. Howe

Service No. 193

Address 11 Grassland Street

Lot #15 Pt. 14

Location *11 Grassland Street Lot #15 pt. 14*

Kind of Pipe

Size

Size of Main

Repair—Renewal—New Service Devine #934

Location MAY 13 1968


Date		Material	Amount	Total	Date		Amount
Jul '66	22'	6" Transite pipe	@5.00	110.00	12-21-67	Deposit	110.00
12-23-67	65'	6" Transite pipe			7-	-66	
	10'	4" Cast Iron pipe				22' 6" Transite	

DATE _____

TOWN OF LEXINGTON — BOARD OF PUBLIC WORKS

SEWER DIVISION

Sketch of Service Here **11**

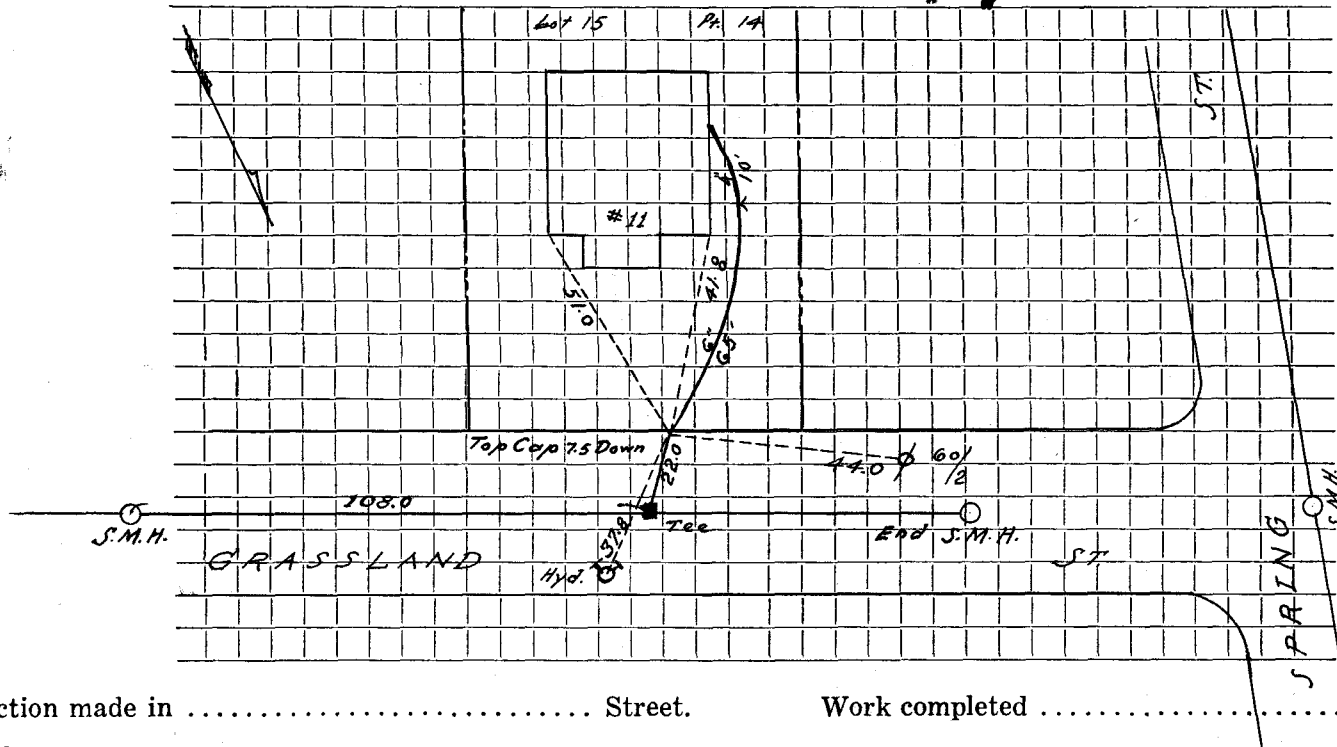

Connection made in Street. Work completed

Remarks:

.....

.....