

Name Donna Realty Trust

Service No. 63

Address 13 Grassland Street

Location

Kind of Pipe

Size

Size of Main

Repair—Renewal—New Service Valeri Const. #1156


Location

Date		Material	Amount	Total	Date		Amount
8-20-68	20'	6" Transite pipe			8-5-68	Deposit	110.00
	10'	4" Cast Iron					
Jul '66	22'	6" Transite pipe	@5.00	110.00	7- - 66	22' 6" Transite	

DATE _____

TOWN OF LEXINGTON — BOARD OF PUBLIC WORKS

SEWER DIVISION

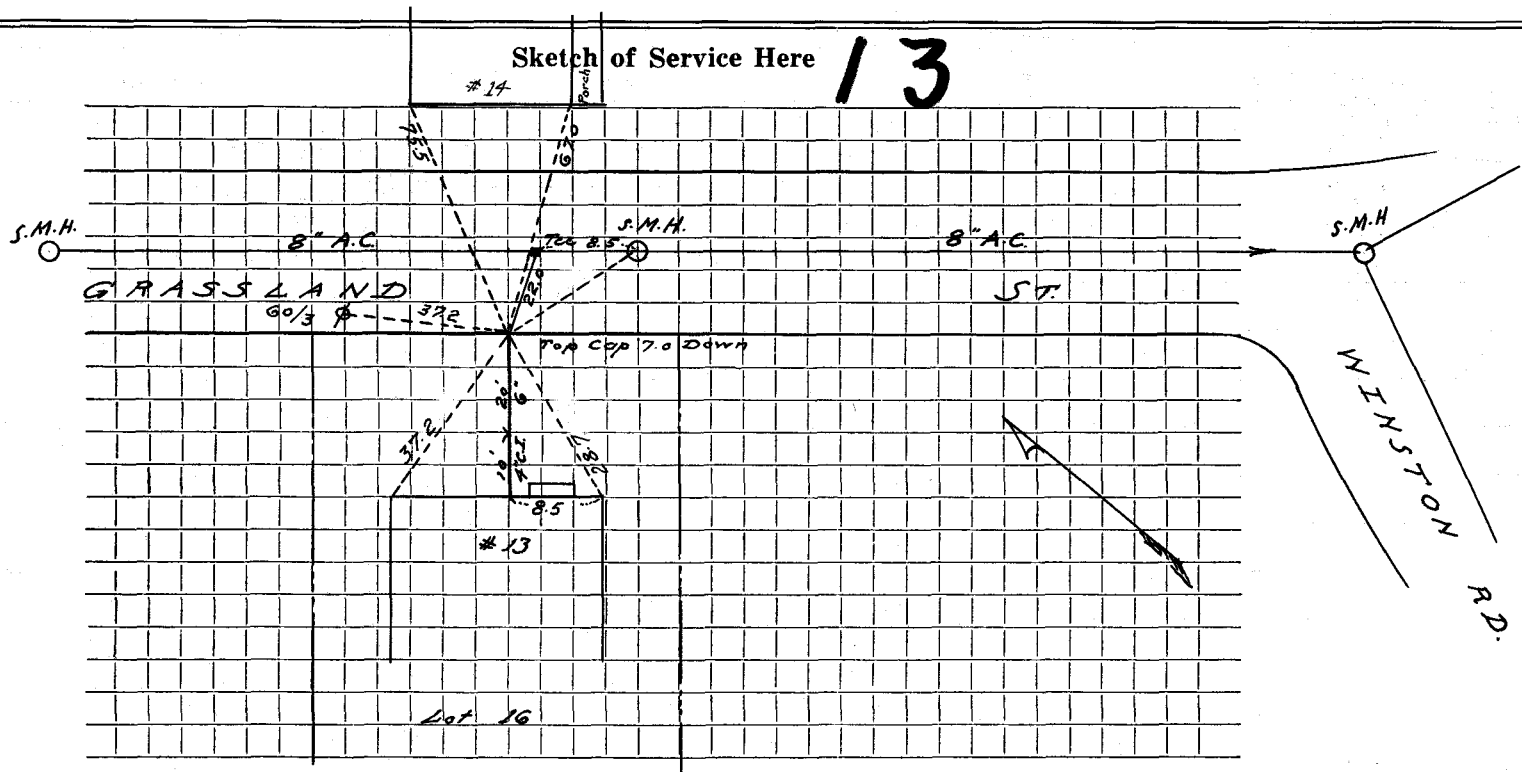

Connection made in Street. Work completed

Remarks:

.....

.....