

Name John Pitken

Service No. 29

Address 14 Grassland Street

Lot #211

Location

Kind of Pipe

Size

Size of Main

ⁱⁿ JUL 24 1967

Repair—Renewal—New Service

Valeri #529

Location


DATE.

TOWN OF LEXINGTON — BOARD OF PUBLIC WORKS

SEWER DIVISION

Sketch of Service Here

14

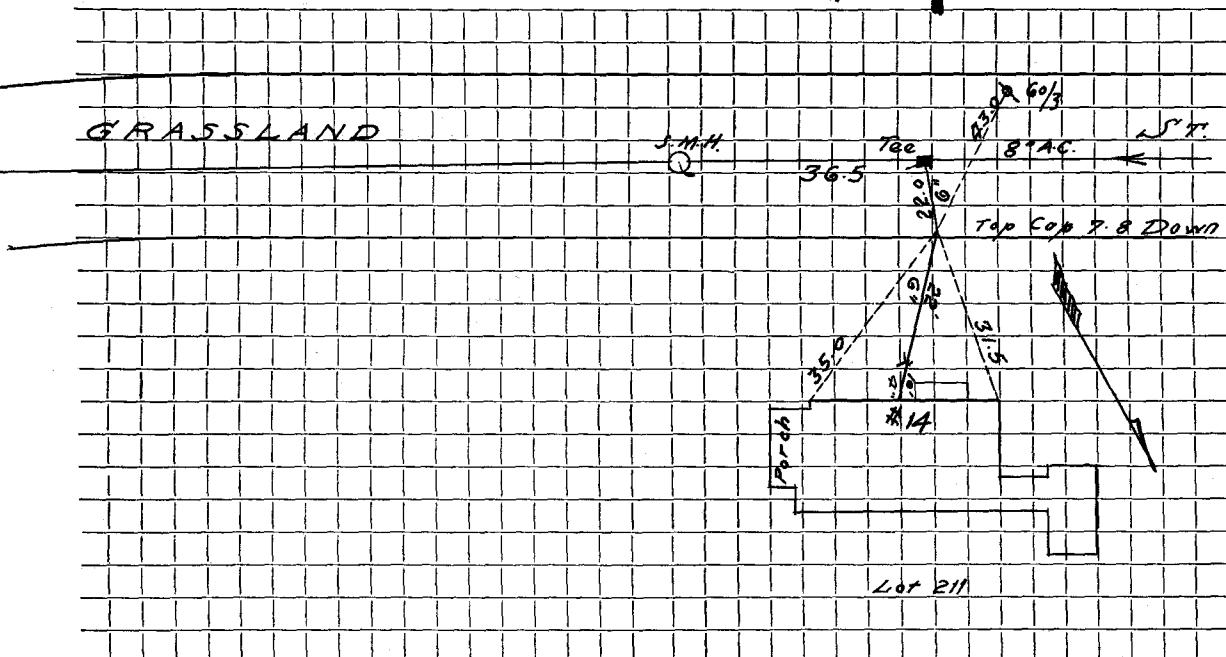

Connection made in Street.

Work completed

Remarks: