


DATE 11-12-97

TOWN OF LEXINGTON — BOARD OF PUBLIC WORKS
SEWER DIVISION

Sketch of Service Here

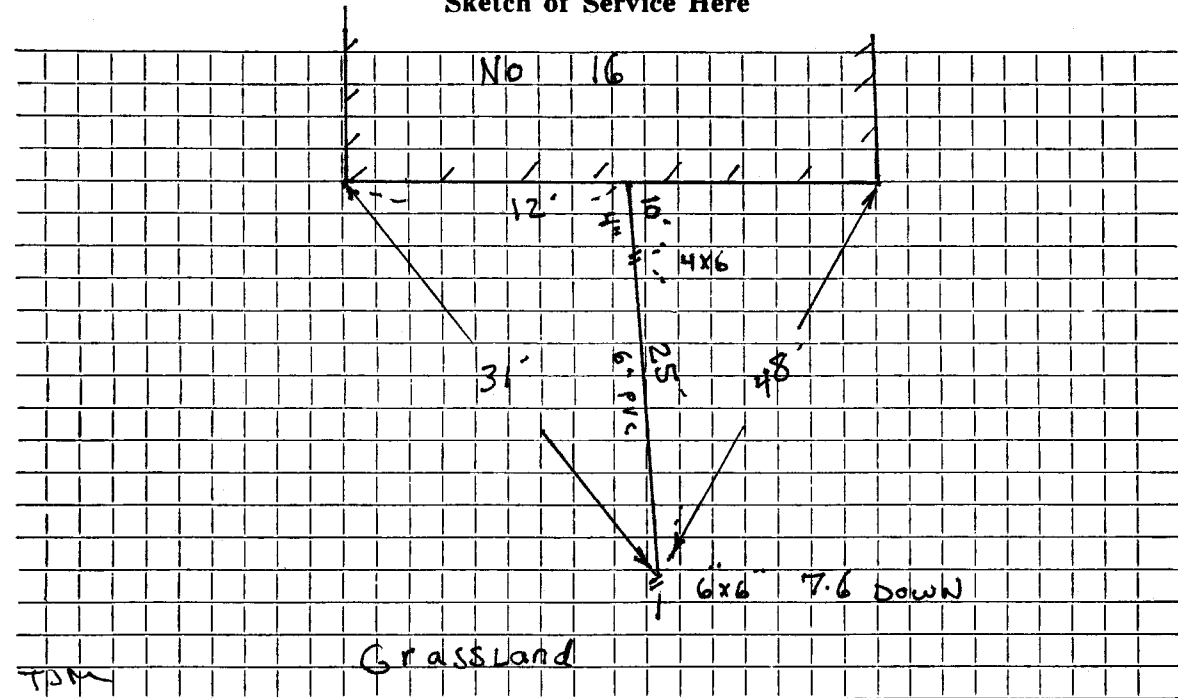

Connection made in Grassland..... Street. Work completed

Remarks:
.....
.....


DATE _____

TOWN OF LEXINGTON — BOARD OF PUBLIC WORKS

SEWER DIVISION

S7.

Sketch of Service Here

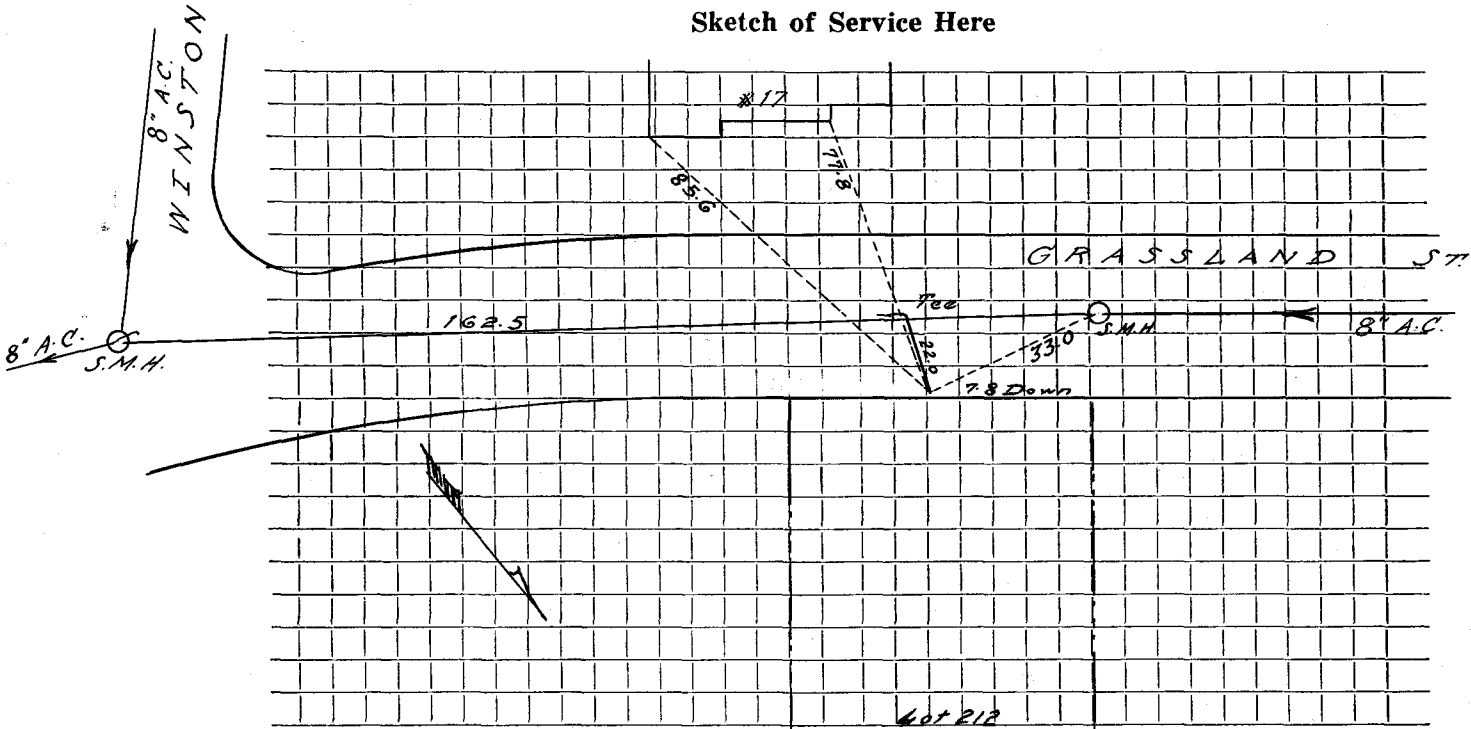

Connection made in Street. Work completed

Remarks:

.....

.....