

Name Rosemary Ley
Address 27 GRASSLAND STREET

Service No.

Location

Kind of Pipe CI & PVC

Size 4" & 6"

Size of Main ♂"

Repair—Renewal—New Service

Eagle #0235


Location

DATE _____

TOWN OF LEXINGTON — BOARD OF PUBLIC WORKS
SEWER DIVISION

Sketch of Service Here

27

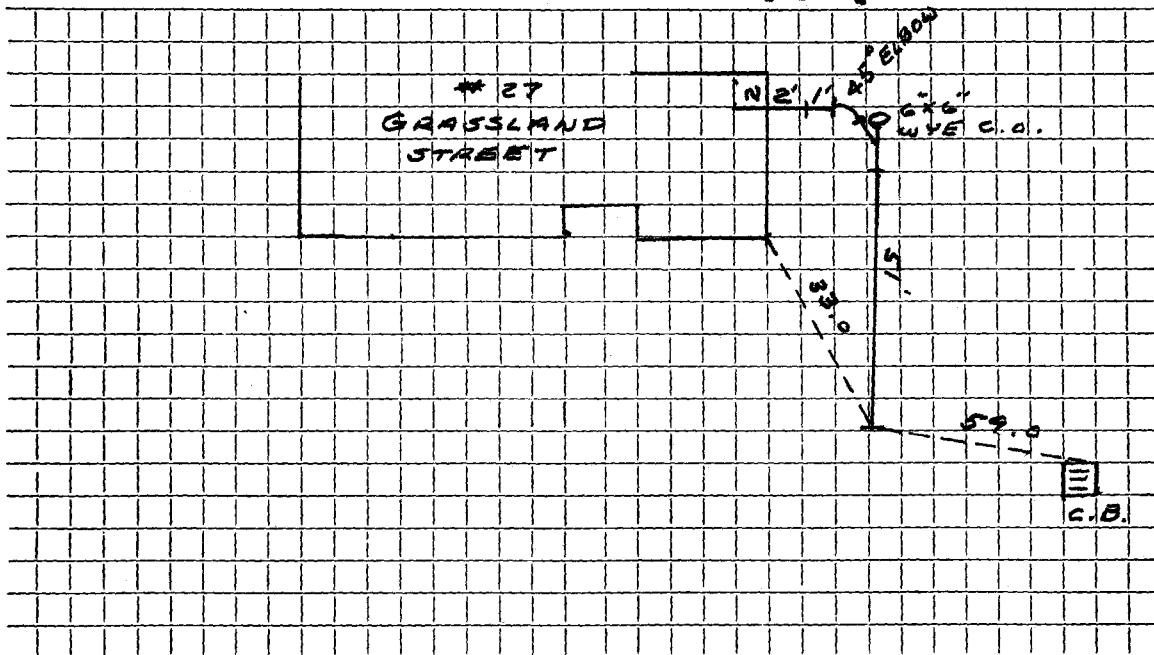

Connection made in GRASSLAND Street. Work completed

Remarks: