

Name

Service No.

Address 42 Grassland Street

Lot #190

Location

Kind of Pipe

Size

Size of Main

Repair—Renewal—New Service

Location

Date

Material

Amount

Total

Date

Amount

~~30' 6" A.C.~~


30' 6" Transite
1 6" Plug
1 6" X 6" Tee

DATE _____

TOWN OF LEXINGTON — BOARD OF PUBLIC WORKS

SEWER DIVISION

Sketch of Service Here

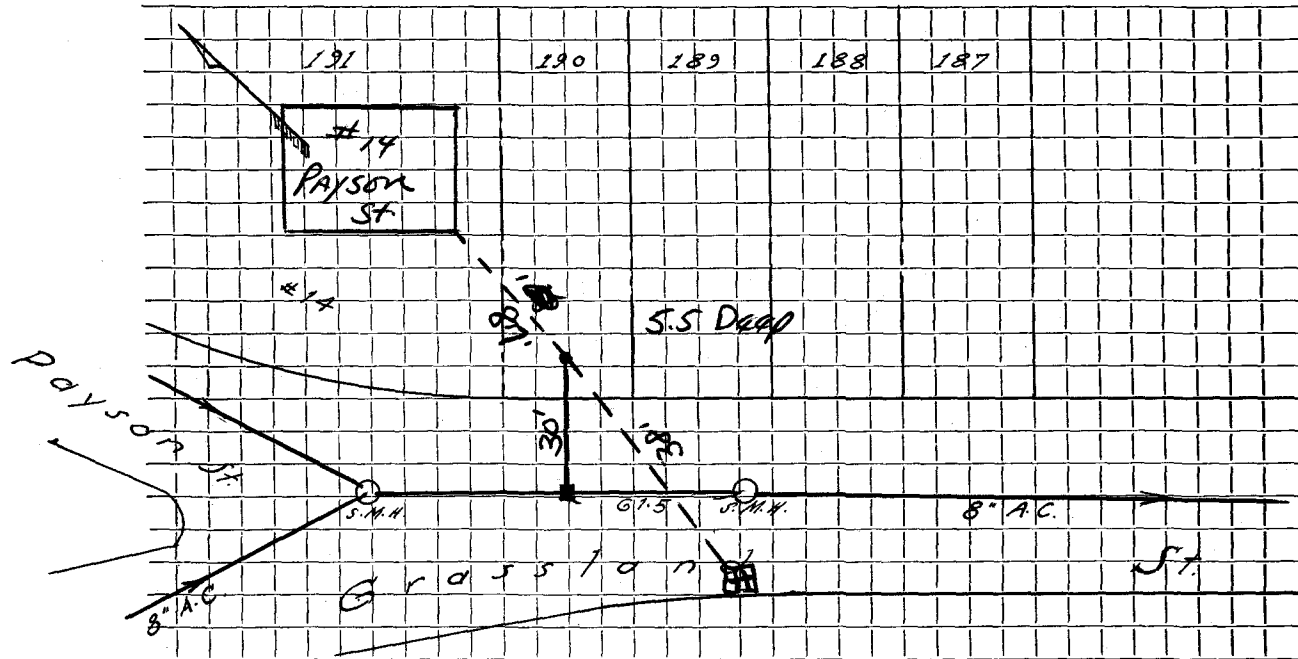

Connection made in Street. Work completed

Remarks:

.....

.....