

Name R. D. Hamilton Const. Co.

Service No. 171

Address 44 Grassland Street

Lot #189

Location

Kind of Pipe

W.O. #1041

Size

Size of Main

Repair—Renewal—New Service  Valeri Const. #2378


Location FEB 10 1975

Date	Material	Amount	Total	Date	Amount
	<del>35' 6" A.C. @.90</del>		31.50	11/12-73	Deposit 147.60
11-21-73	15' - 6" ACP				
	10' - 4" CI				
8/31/73	Labor	76.62		35' 6" Transite	
	10% O.H.	7.66	84.28		
	$\frac{1}{2}$ load Stone		1.75		
	2 load Gravel @2.19		4.38		
	3 Collars @1.88		5.64		
	1 Close Nipple		1.55		
	2 hrs. <del>Truck</del> Shovel @6.50		13.00		
	1 hr. Loader @4.00		4.00		
	$\frac{1}{2}$ hr. Trucking @3.00		1.50		
			147.60		

DATE \_\_\_\_\_

TOWN OF LEXINGTON — BOARD OF PUBLIC WORKS  
SEWER DIVISION

Sketch of Service Here **44**

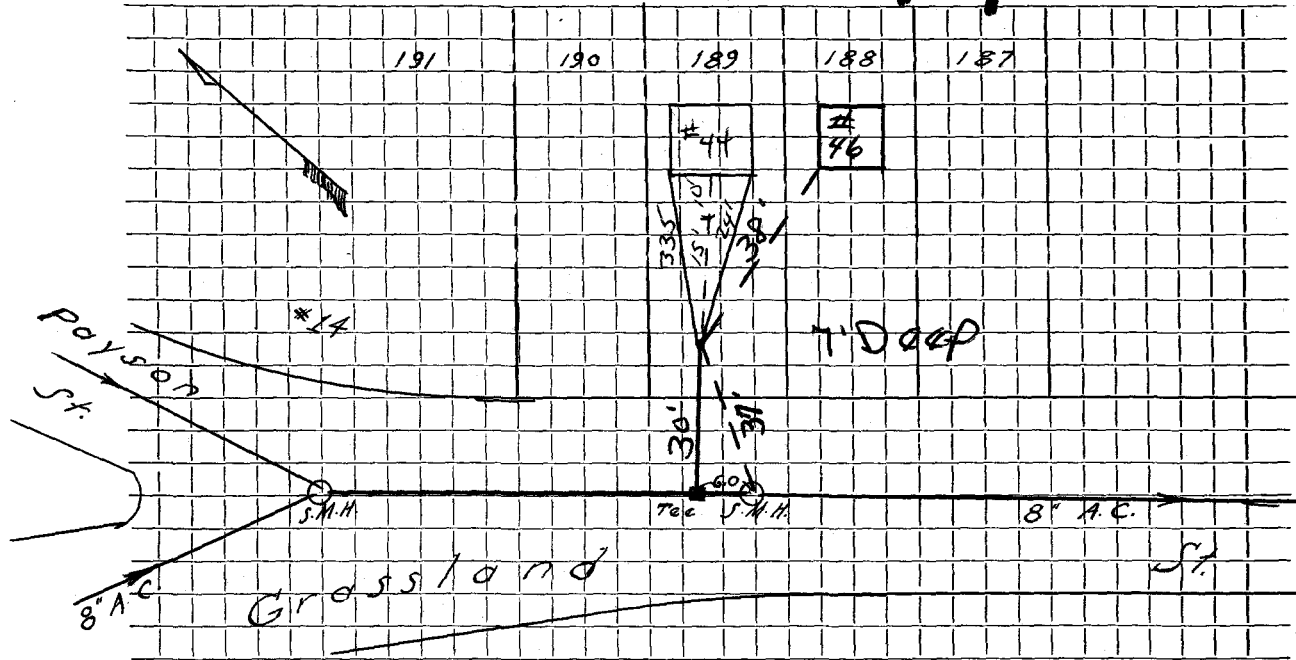

Connection made in ..... Street. Work completed .....

Remarks: .....  
.....  
.....