

Name

Service No.

Address 45 Grassland Street

Lot #28

Location

Kind of Pipe

Size

Size of Main

Repair—Renewal—New Service

Location


Date		Material	Amount	Total	Date	Amount
		30' 6" A.C.				
					30' 6" Transite	
					1 6" Tee	

DATE _____

TOWN OF LEXINGTON — BOARD OF PUBLIC WORKS

SEWER DIVISION

Sketch of Service Here

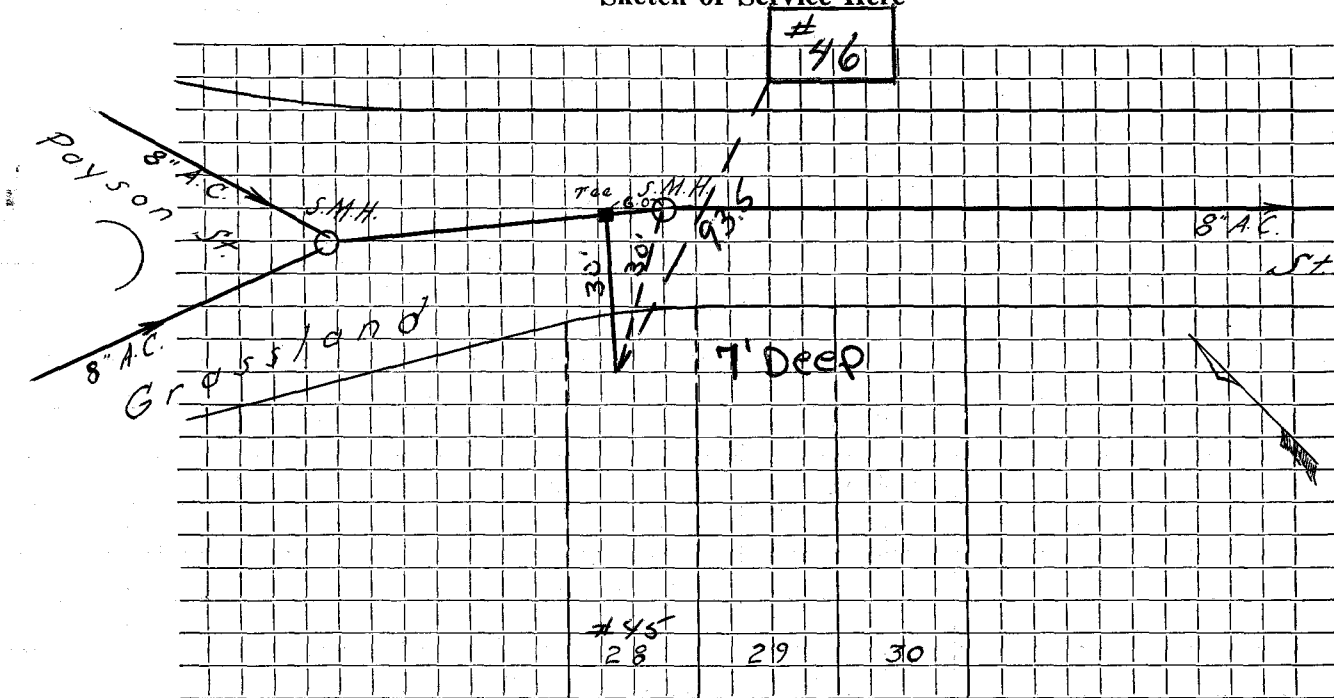

Connection made in Street. Work completed

Remarks:
.....
.....