

Name Stratvern Realty

Service No. 11

Address 46 Grassland Street

Location

Kind of Pipe

Size

Size of Main

~~Repair - Renewal~~ New Service W.O. # 7604 Valeri #1556

Location JUL 27 1970


Date	Material	Amount	Total	Date	Amount
<del>5-27-70</del>	Labor	89 00		<del>4-22-70</del>	200 00
	10% O.H.	8 90	97 90	<del>7-27-70</del>	27 21
	<del>25' 6" Transite pipe .90</del>		22 50		172 79
	<del>1 90° Elbow</del>		5 09	5-27-70	
	<del>2 6" Couplings .60</del>		1 20		25' 6" Transite
	<del>1 6" Plug</del>		3 80		1 6"-90° Elbow
	6 Ton stone 165		9 90		1 6" Plug
	6 " gravel 1.90		11 40		
	2 Hrs. trucking 3.00		6 00		
	2 " shovel 6.50		13 00		
	2 " Pump 1.00		2 00		
			172 79		
6-1-70	36' 6" Transite pipe				
	10' 4" Cast Iron Pipe				

DATE \_\_\_\_\_

TOWN OF LEXINGTON — BOARD OF PUBLIC WORKS  
SEWER DIVISION

Sketch of Service Here

46

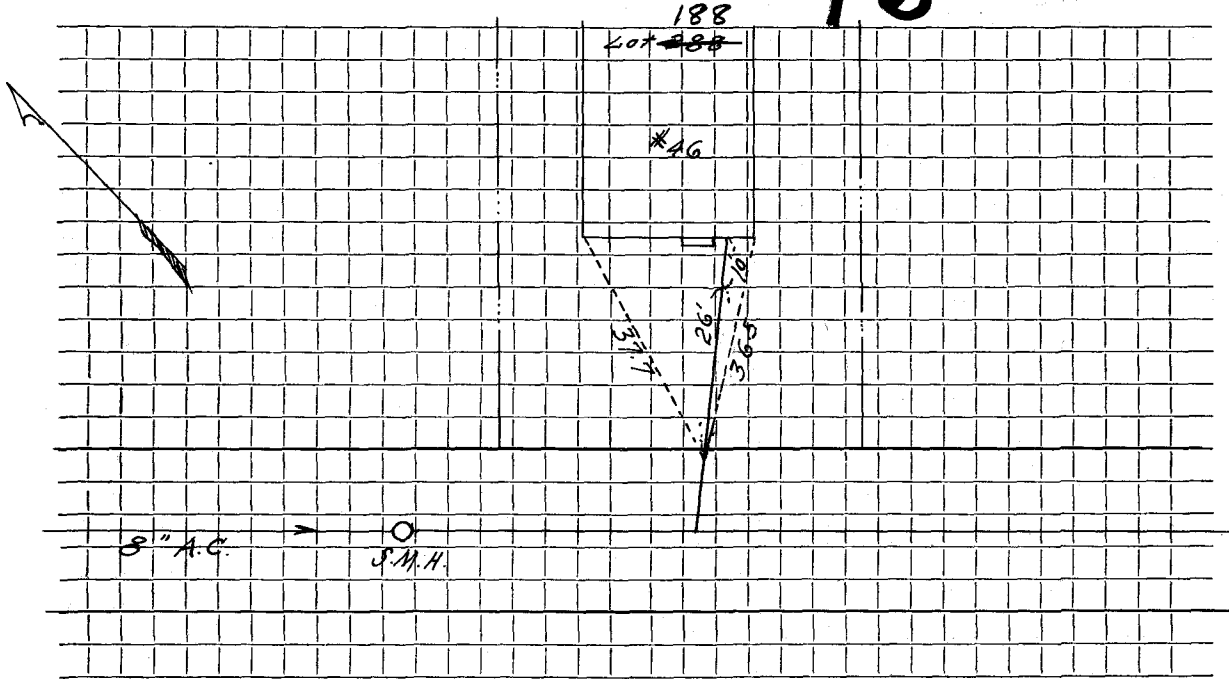

Connection made in ..... Street. Work completed .....

Remarks: .....  
.....  
.....