

Name Woodbury M. Philbrook

Service No. 85

Address 49 Grassland Street

Location

Kind of Pipe

Size

Size of Main

Repair ~~Renewal~~ New ServiceDeFlice #1925
W.O. # 8199

Location JAN 17 1972


Date	Material	Amount	Total	Date	Amount	
10/21/71	Labor	101 82		10-12-71	Deposit	250 00
	10% O.H.	10 18	112 00	1-17-72	Refund	44.34
10'	6" Transite pipe .90		9 00			285 66
1	6" Saddle Saddle		15 95	10-21-71		
1	22½" Sweep		6 83		20' 6" Transite	
2	3 x 6" Nipples 4.00		8 00		1 6" Saddle	
1	6" Cap		1 63		1 6"-22½" Sweep	
2	Ton 3/4" Stone 1.75		3 50		2 6" X 3' Nipples	
2	Load gravel 14.00		28 00		1 6" Cap	
2	Hrs. truck 3.00		6 00			
1½	" shovel 6.50		9 75			
1	" loader		5 00			
			205 66			
1-18-72	237' 6" Transite pipe					
	30' 4" Cast Iron pipe					

DATE _____

TOWN OF LEXINGTON — BOARD OF PUBLIC WORKS

SEWER DIVISION

Sketch of Service Here

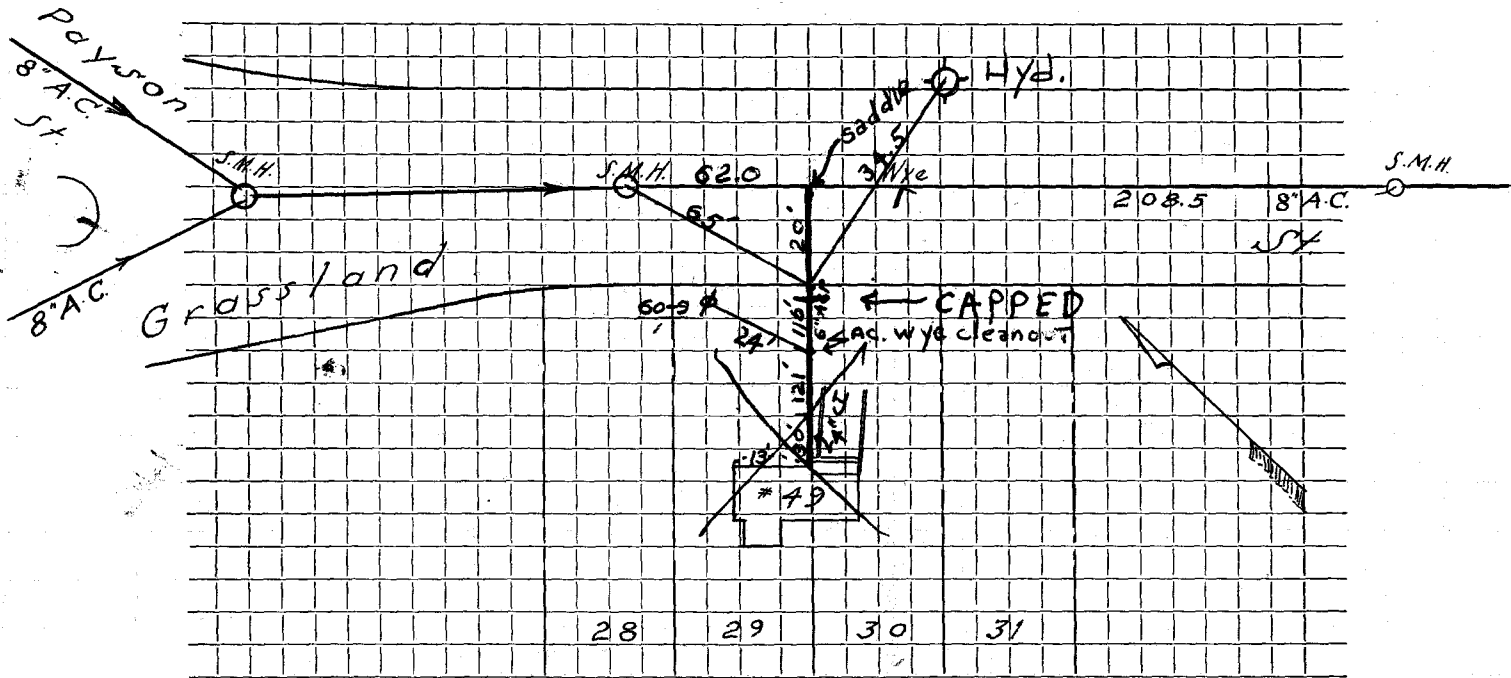

Connection made in Street. Work completed

Remarks: Sewer Cap BACK EDGE of R.D.
WATER off AT Curb