

Name Mr. Peter Sowkow

Service No. 78

Address 52 Grassland Street

Lot #186 #7316 Cont. DeFlice Bros.

Location

Kind of Pipe

Size

Size of Main

~~Repair~~ ~~Renewal~~ New Service

Location JAN 27 1969


Date	Material	Amount	Total	Date	Amount
9-25-68	Labor	85 44		7-30-68	200 00
	10% O.H.	8 54	93 98	1-27-69	57 07
20'	6" Transite pipe .88		17 60		142 93
1	Elbow		2 35	9-25-68	
4	Hrs. Shovel @ 6.50		26 00	20' 6" Transite	
1	" Trucking		3 00	1 6" Elbow	
10-11-68	30' 6" Transite pipe		142 93		
	10' 4" Cast Iron pipe				

DATE _____

TOWN OF LEXINGTON — BOARD OF PUBLIC WORKS
SEWER DIVISION

Sketch of Service Here

52

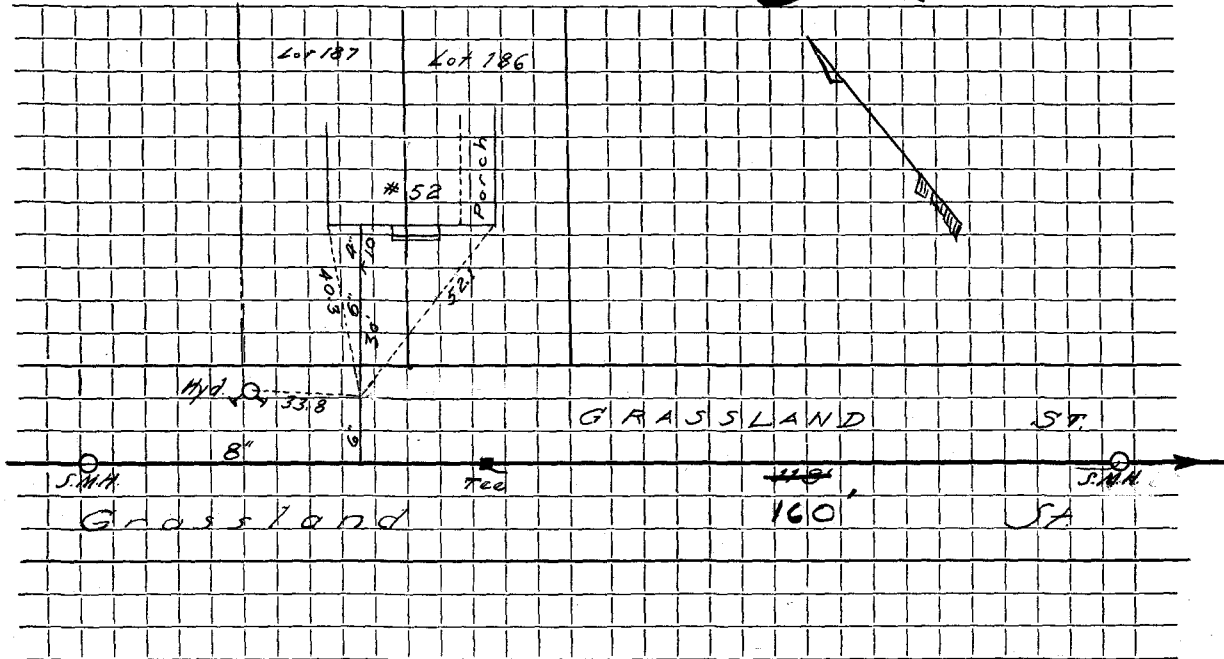

Connection made in Street. Work completed

Remarks:

.....

.....