

Name

Service No.

Address 55 Grassland Street

Lot #32

Location

Kind of Pipe

Size

Size of Main

Repair—Renewal—New Service

Location

Date

Material

Amount

Total

Date

Amount

25' 6" A.C.

8-30-73

25' 6" Transite

1 6" Close Nipple


1 Elbow

DATE _____

TOWN OF LEXINGTON — BOARD OF PUBLIC WORKS

SEWER DIVISION

Sketch of Service Here

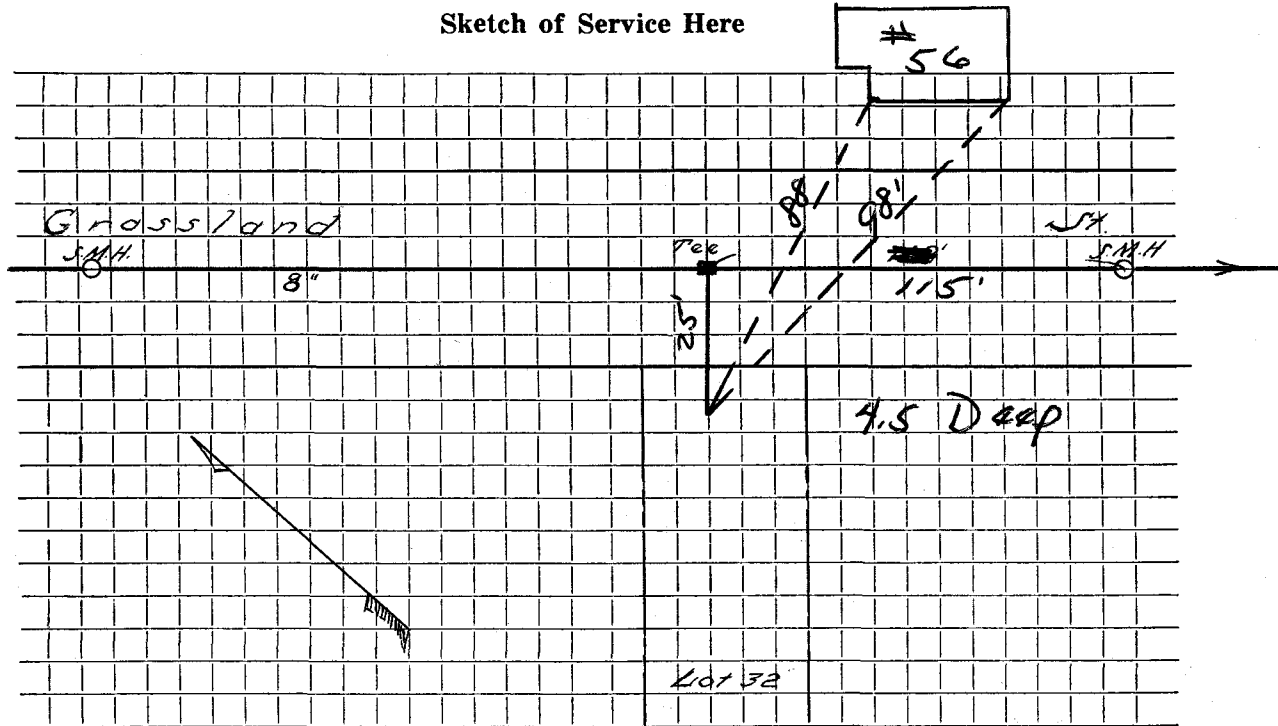

Connection made in Street. Work completed

Remarks:
.....
.....