

Name

Service No.

Address 58 Grassland Street

Lot #183

Location

Kind of Pipe

Size

Size of Main

Repair—Renewal—New Service

Location

Date

Material

Amount

Total

Date

Amount

~~35' 6" A.C.~~

8-30-73


35' 6" Transite

1 6" Close Nipple

DATE _____

TOWN OF LEXINGTON — BOARD OF PUBLIC WORKS
SEWER DIVISION

Sketch of Service Here

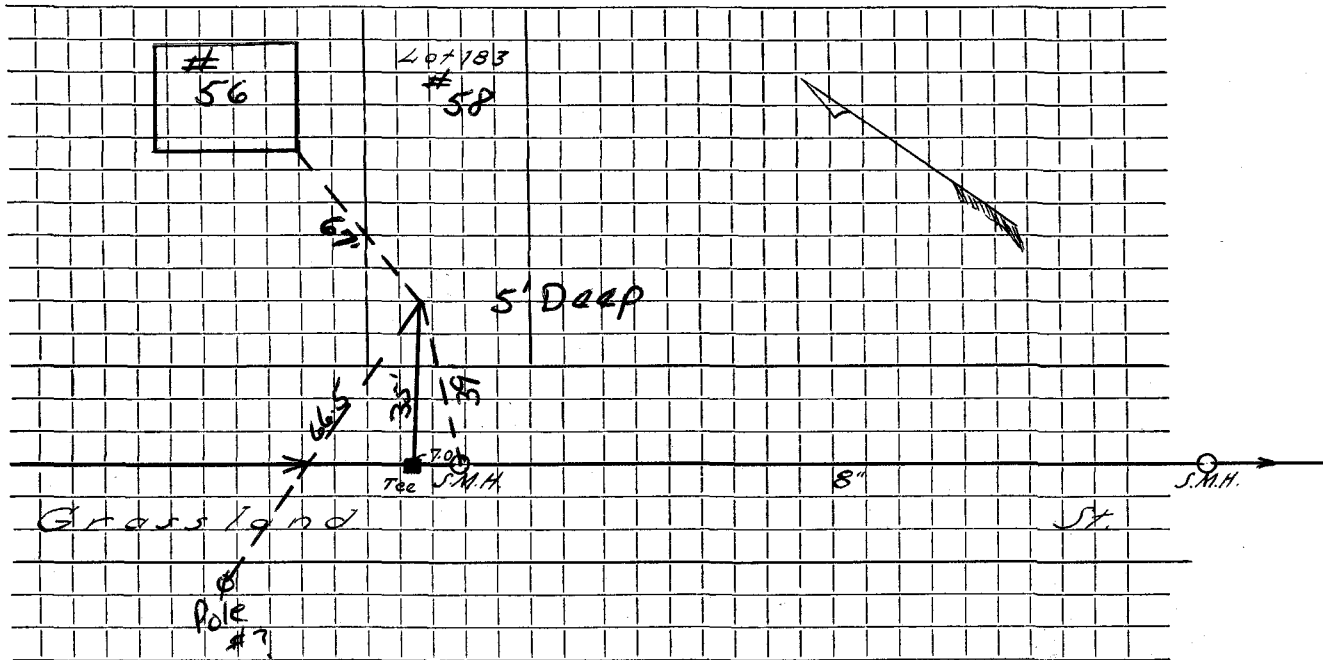

Connection made in Street. Work completed

Remarks:
.....
.....