

Name

Service No.

Address

6 Grassland Street

Lot 208

Location

6 Grassland Lot 208

Kind of Pipe

Size

Size of Main

Repair—Renewal—New Service

Location

Date

Material

Amount

Total

Date

Amount

~~Jul '66 16' 6" Transite pipe @ 5.00~~

80.00

7. - 66


16' 6" Transite

DATE _____

TOWN OF LEXINGTON — BOARD OF PUBLIC WORKS

SEWER DIVISION

Sketch of Service Here

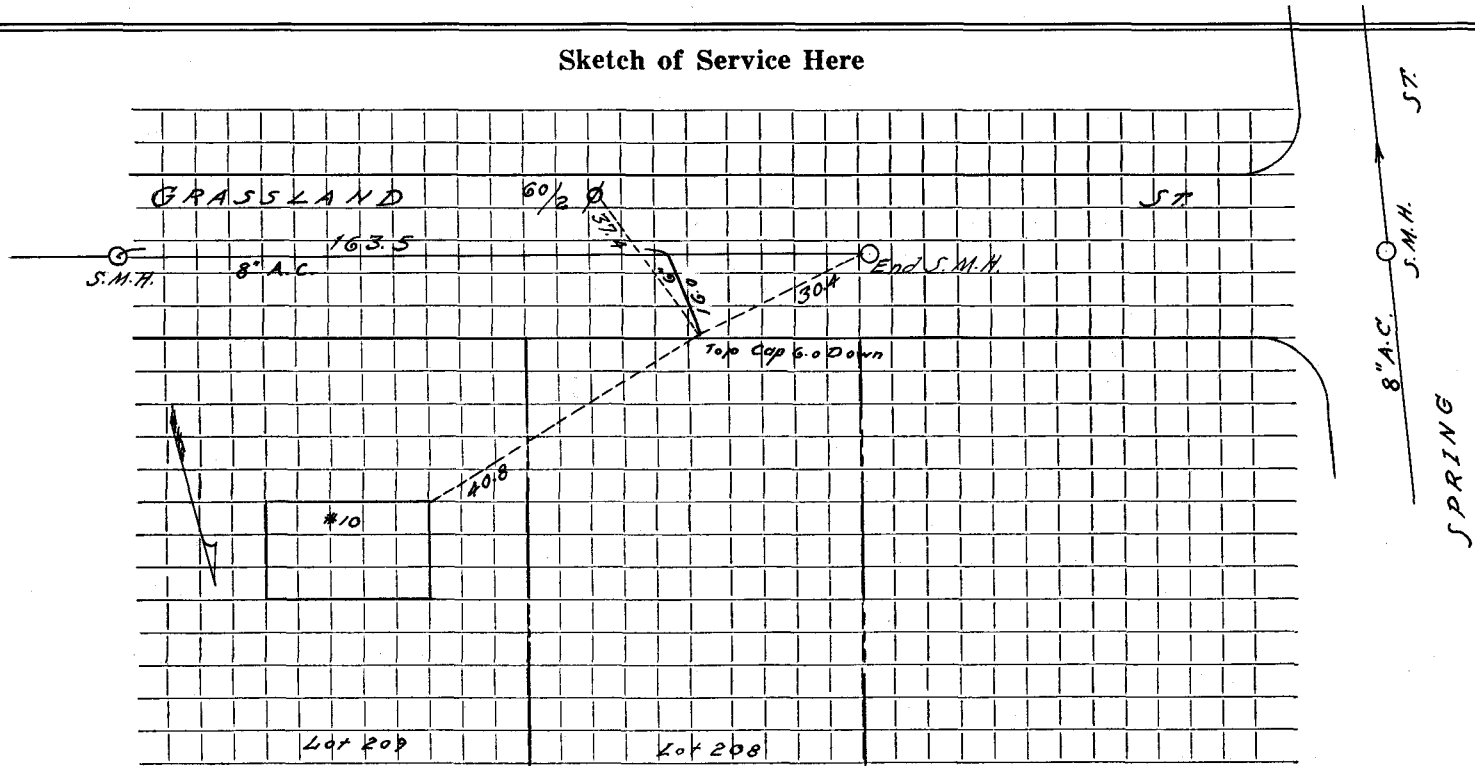

Connection made in Street. Work completed

Remarks:
.....
.....