

Name

Service No.

Address 60 Grassland Street

Lot #182

Location

Kind of Pipe

Size

Size of Main

Repair—Renewal—New Service

Location

Date

Material

Amount

Total

Date

Amount

~~35' 6" A.C.~~

8-30-73

35' 6" Transite


2 6"-22 1/2° Bends

1 6" Cap

DATE \_\_\_\_\_

TOWN OF LEXINGTON — BOARD OF PUBLIC WORKS  
SEWER DIVISION

Sketch of Service Here

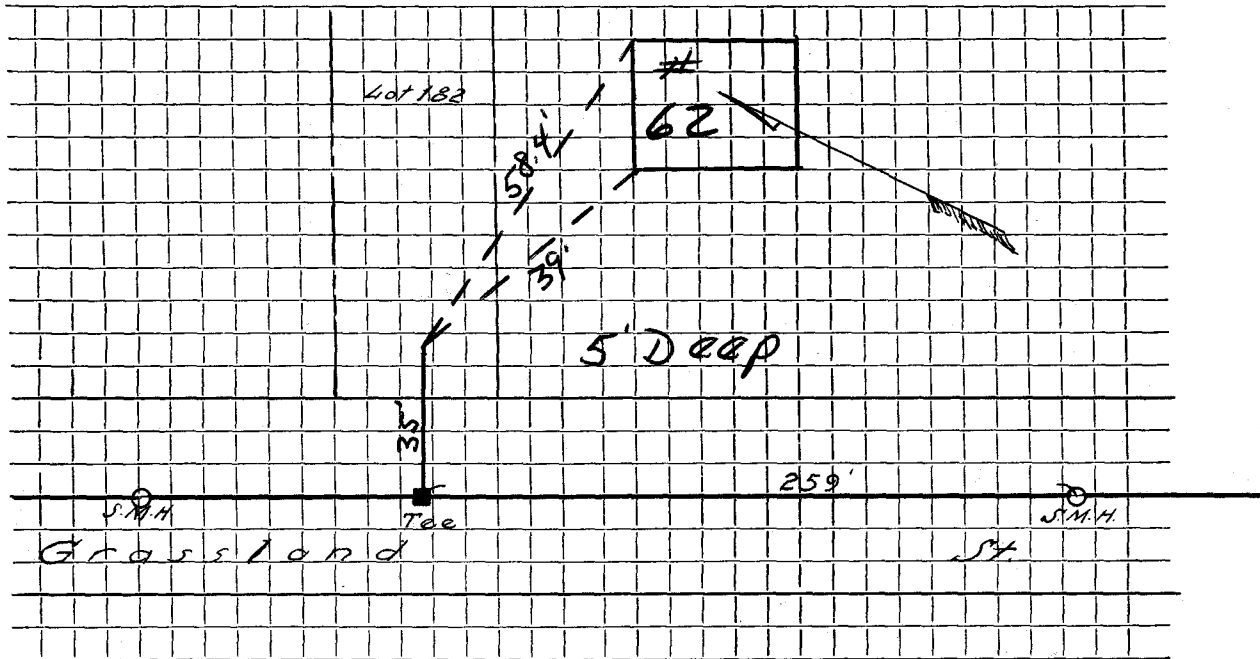

Connection made in ..... Street. Work completed .....

Remarks: .....  
.....  
.....