

Name

Service No.

Address 61 Grassland Street

Lot #35

Location

Kind of Pipe

Size

Size of Main

Repair—Renewal—New Service

Location

Date

Material

Amount

Total

Date

Amount

~~25' 6" A.C.~~

8-27-73

25' 6" Transite


1 6" X 6" Tee

1 6" Cap

DATE _____

TOWN OF LEXINGTON — BOARD OF PUBLIC WORKS
SEWER DIVISION

Sketch of Service Here

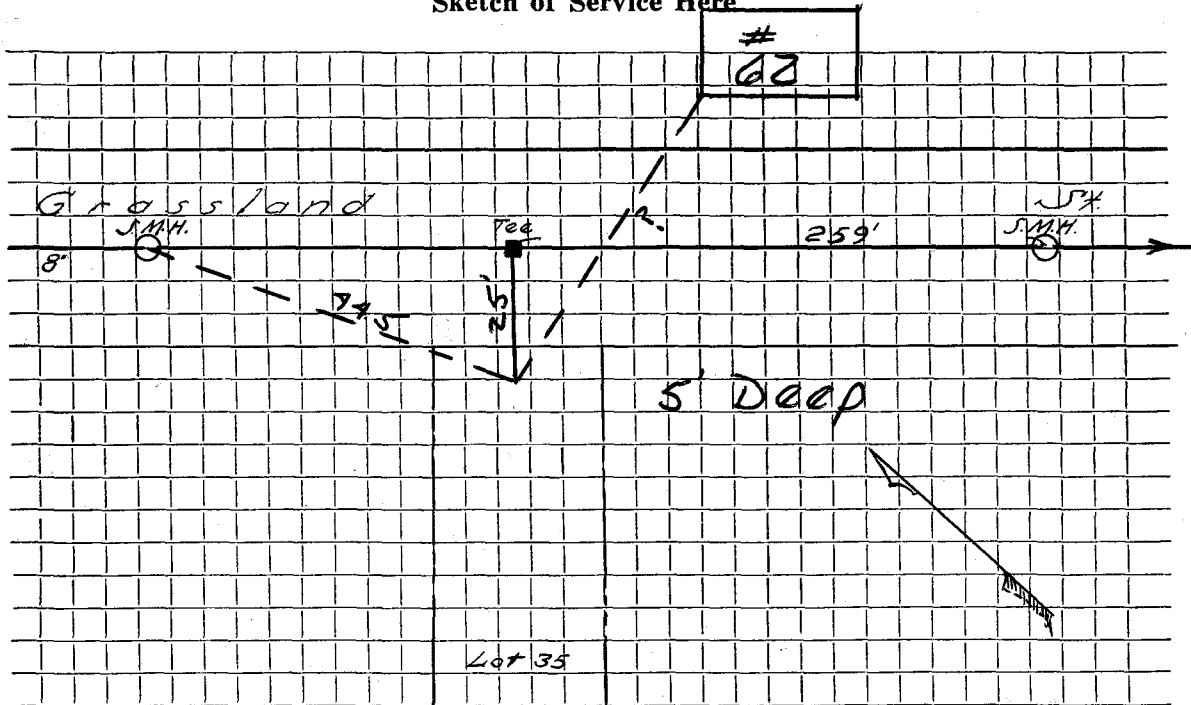

Connection made in Street. Work completed

Remarks:
.....
.....