

Name Donna Realty Trust

Service No. 78

Address 62 Grassland Street
Lot #181

Location

Kind of Pipe

Size

Size of Main

~~Repair~~ ~~Renewal~~ New Service Valeri #1431
W.O. #6709

Location

SEP 2 1969

Date	Material	Amount	Total	Date	Amount
8/13/69	Labor	139 36		8-5-69	200 00
	10% O.H.	13 94	153 30	9-2-69	8 53
	28' 6" Transite pipe .88		24 64		208 53
	1 Elbow		4 09		
	2 Hrs. Trucking 1.50		3 00	8-13-69	
	3 " Shovel 6.50		19 50	28' 6" Transite	
	4 " Pump 1.00		- 4 00	1 6" Elbow	
			208 53		
8/21/69	25' 6" Transite pipe				
	10' 4" C.I. Pipe				


DATE _____

TOWN OF LEXINGTON — BOARD OF PUBLIC WORKS

SEWER DIVISION

Sketch of Service Here

62

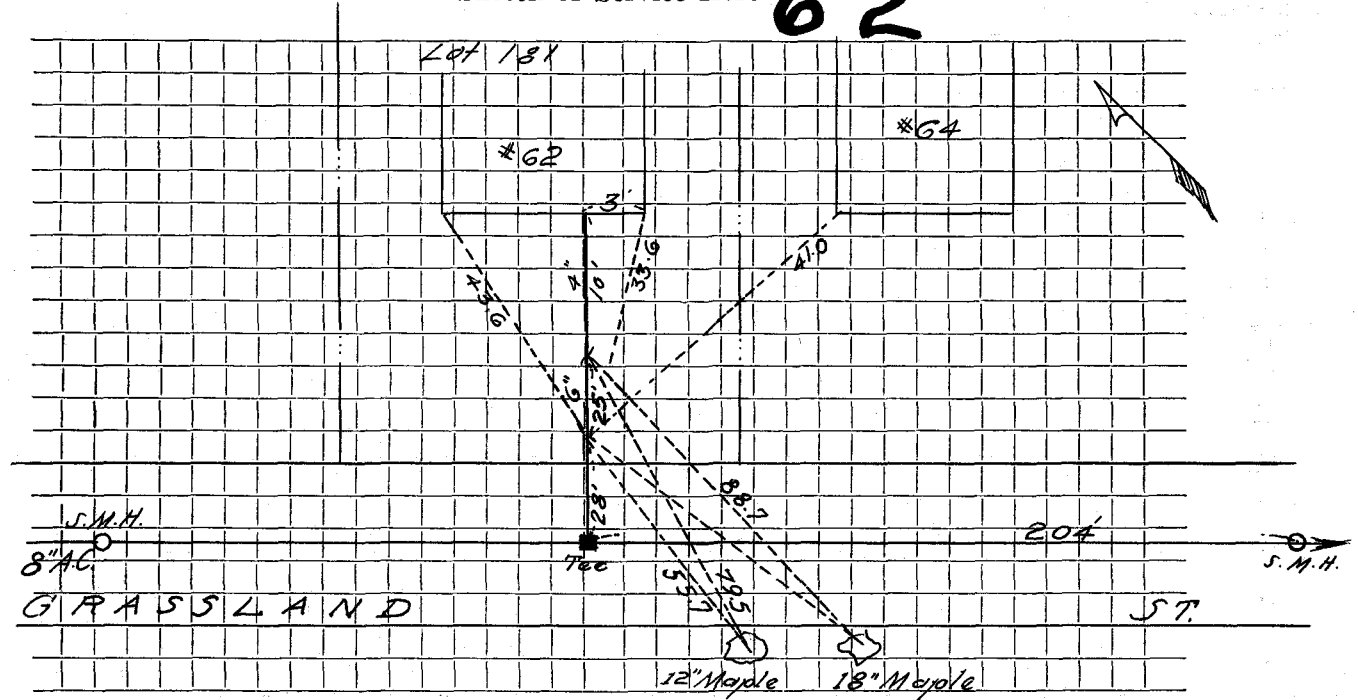

Connection made in Street. Work completed

Remarks:
.....
.....